

Map No. _____ Sec. 13 Twp. 29 R. 3
 Well No. #2 Piper Farm _____
Lucky Eight Company _____

NORTH

WEST



EAST

SOUTH

Location _____

Rig Up _____

Drilling Remarks:

Drilling Remarks:

RECORD

Cased _____ in. _____ ft.

Sand _____

Gas _____

Oil _____

Total Depth _____

PRODUCTION

1st 24 hrs. Nat. _____

1st 24 hrs. after shot _____

Gas _____ cu. ft

Dry Hole _____


Abandoned _____

Map No. K11 Sec. 13 Twp. 29 R. 4Well No. 2 Pigeon FarmLucky 8 Company

NORTH

WEST

EAST

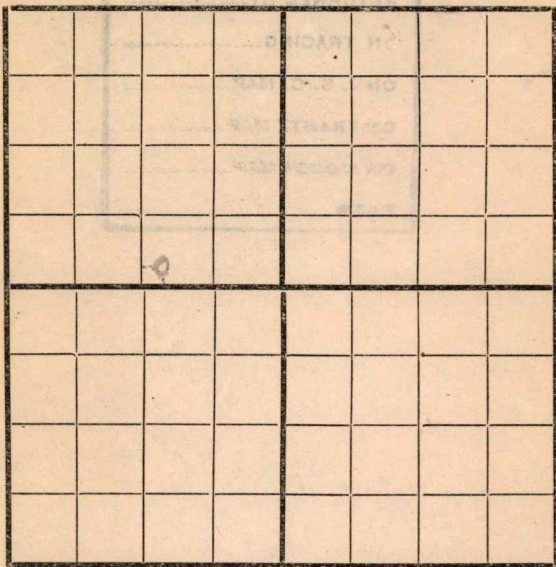

SOUTH

Location ✓Rig Up ✓

Drilling and remarks

(250' Location)

RECORD

Cased _____ in. _____ Ft.

Sand _____

Gas _____

Oil _____

Total Depth _____

PRODUCTION

1st 24 hrs. Nat. _____

1st 24 hrs. after shot _____

Gas _____ Cu. Ft.

Dry Hole _____

Abandoned _____

FIRST REPORT


Date

6/21/1917 Scout

Map No. _____ Sec. 13 Twp. 29 R. 4Well No. 2 Piper Farm _____Lucky 8 Company _____

NORTH

WEST

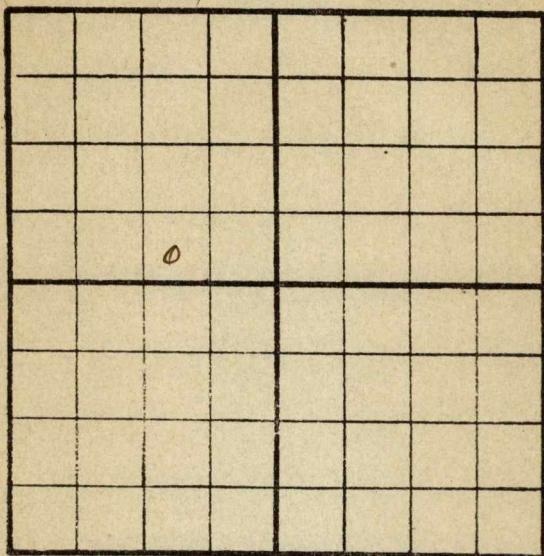

EAST

SOUTH

Location _____

Rig up _____

Drilling and remarks:

1,500,000 Cu. ft. Gas
 Gas at 1865 to
 1874

Drilling 1885.

RECORD

Cased _____ in. _____ Ft.

Sand _____

Gas 1865-1874Oil 90

Total Depth _____

PRODUCTION

1st. 24 hrs. Nat. _____

1st. 24 hrs. after shot _____

Gas _____ Cu. Ft.

Dry Hole _____

Abandoned _____


Date

7/24 1917 Condiff Scout

Map No. 13 Sec. 29 Twp. 3 R. 3Well No. 2 Piper Farm
Lucky 8 Company

NORTH

WEST

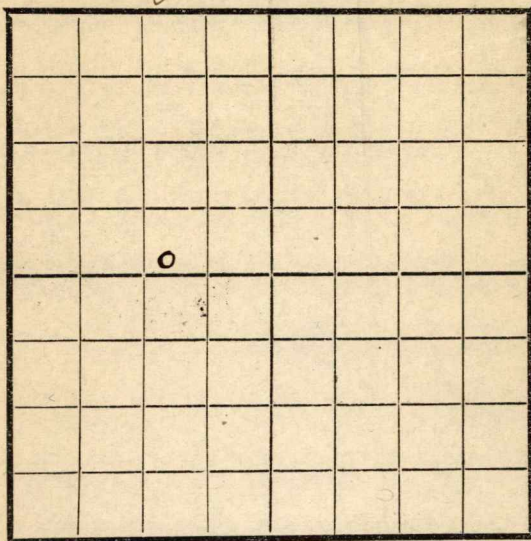

EAST

SOUTH

Location -----

Rig Up -----

Drilling and remarks

*This should
probably be
13-29-3
instead of
13-29-4*

RECORD

Cased ----- in. ----- Ft.

Sand -----

Gas -----

Oil -----

Total Depth -----

PRODUCTION

1st 24 hrs. Nat. -----

1st 24 hrs. after shot -----

Gas ----- Cu. Ft.

Dry Hole -----

Abandoned -----


Date

8/10, 1917 Conley Scout

Map No. none Sec. 13 Twp. 29 R. 3Well No. 2 Pipe Farm
Lucky 8 Company

NORTH

WEST

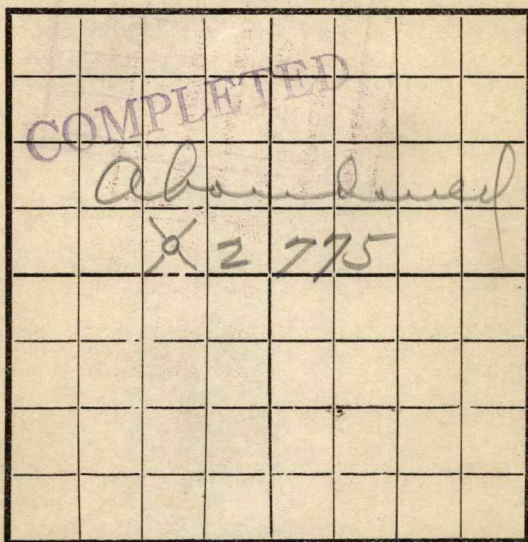

EAST

SOUTH

Location -----

Rig Up -----

Drilling and remarks

Dry and
Abandoned
2775

RECORD

Cased ----- in. ----- Ft.

Sand -----

Gas -----

Oil -----

Total Depth -----

PRODUCTION

1st 24 hrs. Nat. -----

1st 24 hrs. after shot -----

Gas ----- Cu. Ft.

Dry Hole -----

Abandoned -----


Date

10/31, 191 *7* *Cordiff* Scout

Map No. K11 Sec. 13 Twp. 29 R. 4E

Well No. _____ Farm _____
 _____ Company _____

NORTH

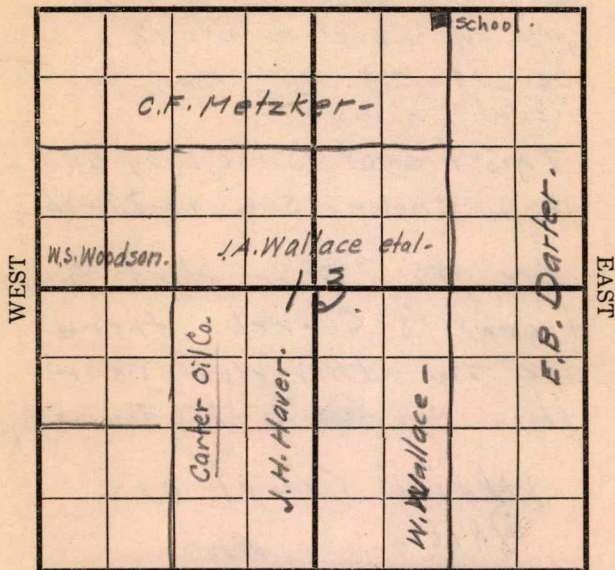

SOUTH

Location _____
 Rig Up _____
 Drilling and remarks _____

RECORD

Cased _____ in. _____ Ft.
 Sand _____
 Gas _____
 Oil _____
 Total Depth _____

PRODUCTION

1st 24 hrs. Nat. _____
 1st 24 hrs. after shot _____
 Gas _____ Cu. Ft.
 Dry Hole _____
 Abandoned _____

Date

191

Scout

Our Maps Show all together -
Different Land owners in .

Sec. 13 - 29 - 4 - than you -
ticket shows -

This ticket is the way our
map - show - Sec. 13 - 29 - 4 -

Are you - sure that your
ticket is Corret - there
are no other Well near
this - Sec. ~~13~~ in this Township.

What is Corret on -
this - Rur

E. P. Brann

taken off tracing
by Rur - Rur

PAID 3.00
PAID 2.00
ON MOODY MAP
Pox