


Section 13 Township 26 Range 11 E

Well No. #5 Seinforth (Steinforth)

Company L. M. McCormick

NORTH

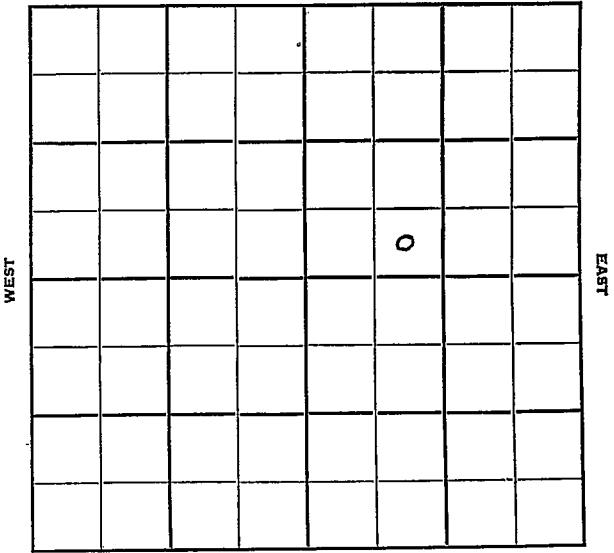

SOUTH

WEST

EAST

Sec. 13 Twp. 26 R. 14E

Well No. #5 Seinforth Farm

L. M. McCormick Company

Contractor


_____ Ft. from N. Line

330' Ft. from S. Line

_____ Ft. from E. Line

990' Ft. from W. Line

SE SW NE

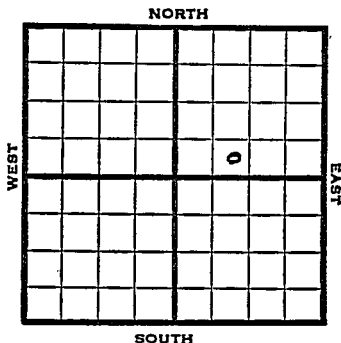

1951

Elev. - REPORT

1/24

Spud 1-17-51

10" @ 30'

Drlg. 200'

5/29

Spud 1-17-51

Oil Well TD 1271

10" @ 30'

Sand 1250-68 7" @ 1223

TD 1271 PB 1266

B/2 bo & wtr Comp. 6 bopd

COMPLETED

County Woodson State Kansas

Sec. 13 (Blk. Twp.) 26 (Sur. Rge.) 14E Map No.

Operator L. M. McCormick

Well No. 5 Farm Seinforth

Elev. _____ Location SE SW NE

330 Ft. From S Line NE

990 Ft. From W Line Quarter

1st. Report JAN 24 1951

Completion _____

Remarks _____

Spudding Date 1-17-51

Drlg. Data _____

10" @ 30 drlg. 200

J. E. TYRA

