


Woodson

Map No. Kansas Sec. 22 Twp. 26 R. 14
Well No. 1 ~~Woodson~~ Pendley (KLS ORV) Farm

Brinegar et al

Company

NORTH

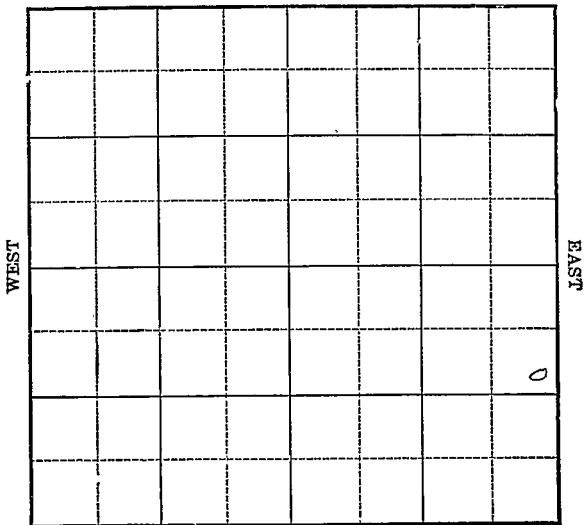

SOUTH

Location _____

Drilling Remarks _____

Rig Up _____

Drilling Remarks _____

RECORD

Cased _____ in. _____ ft.

Sand _____

Gas _____

Oil _____

Total Depth _____

PRODUCTION

1st 24 hrs. Nat. _____

1st 24 hrs. after shot _____

Gas _____ cu. ft.

Dry Hole _____

Abandoned _____

Woodson

Map No. MAN Sec. 22 Twp. 26 R. 14

Well No. 1 unknown Pendley (KGS ORL) Farm


Brinegar et al Company

1120 Ft. from N. Line

..... Ft. from S. Line

200 Ft. from E. Line

..... Ft. from W. Line

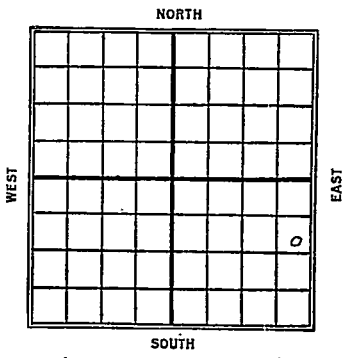

1926 First and Completed

Date

REPORT

8/11

2.5 Bbls natural

23 gravity, sand 1242-85

T.D. 1285'

Woodson

KANSAS

Map No. _____ Sec. 22 Twp. 26 R. 14

Well No. 1 ~~W.A. Foster~~ Pindley (K65DRL)

Drinegan et al Company

Contractor

FIRST REPORTS

SECTION PLAT

1120 COMPLETED
Ft. from N. Line

Ft. from S. Line

200 Ft. from E. Line

Ft. from W. Line

			6

Location _____

Rig up _____

Drilling and Remarks:

25 lb returned

23 Gravity

RECORD

Cased _____ in., _____ ft.

Sand 1242-1285

Gas _____

Oil _____

Total Depth 1285

PRODUCTION

1st 24 hrs. Nat. _____

1st 24 hrs. after shot _____

Gas _____ Cu. Ft.

Dry Hole _____

Abandoned _____

Date

AUG 1 1 1926

192

CHAS. L. SHERWOOD

Scout