


Section 14 Township 29 Range 3E

Well No. 17<sup>#2</sup> Tory

Company Chas. E. Gould

NORTH

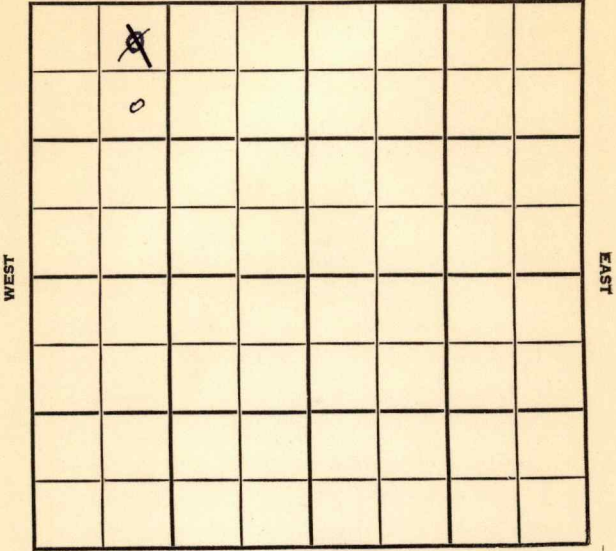

SOUTH

WEST

EAST

Butler

KANSAS

SEC. 14	TWP. 29	R. 3E
------------	------------	----------

WELL NO. ~~#2~~ ~~X~~ #2 Tory FARM

COMPANY  
CONTRACTOR Chas. E. Gould

Salina Drlg.  
Wildcat.


990  
330 Ft. from N. Line

Ft. from S. Line

Ft. from E. Line

900 Ft. from W. Line

SE  
NE NW NW

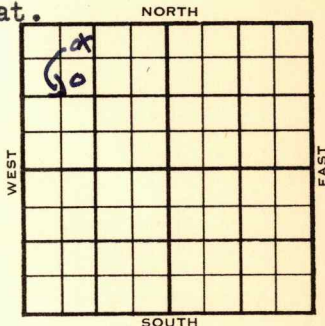

1954	ELEVATION 1252'	REPORT
------	--------------------	--------

9/8

~~10~~  
9/29

Location

Spud 9-12-54 D & A TD 2282  
 8" @ 110 Layton 2040 KC 2251  
 DST 2278-83 open 1 hr rec 6' HOCM  
 625# TD 2282 D & A

**ABANDONED**

KANSAS

Map No. \_\_\_\_\_ Sec. 14 Twp. 29 R. 3E

Well No. 1 Tory

Chas. E. Gould \_\_\_\_\_ Company

**CORRECTION**

Contractor

SE NW NW

SECTION PLAT

990 Ft. from N. Line

\_\_\_\_\_ Ft. from S. Line

\_\_\_\_\_ Ft. from E. Line

900 Ft. from W. Line


Butler Co.

Location \_\_\_\_\_

Rig up \_\_\_\_\_

Drilling and Remarks: \_\_\_\_\_

Reported

NE NW NW

2 Tory

RECORD

Cased \_\_\_\_\_ in., \_\_\_\_\_ ft.

Sand \_\_\_\_\_

Gas \_\_\_\_\_

Oil \_\_\_\_\_

Total Depth \_\_\_\_\_

PRODUCTION

1st 24 hrs. Nat. \_\_\_\_\_

1st 24 hrs. after shot \_\_\_\_\_

Gas \_\_\_\_\_ Cu. Ft.

Dry Hole \_\_\_\_\_

Abandoned \_\_\_\_\_

Date

SEP 15 1954

FABEN GILSTRAP

Scout

Map No. \_\_\_\_\_ Sec. 14 Twp. 29 R. 3E

Well No. 2 Tory

Chas. E. Gould Company

### CORRECTION

Contractor

SE NW NW

### SECTION PLAT

990 Ft. from N. Line

\_\_\_\_\_ Ft. from S. Line

\_\_\_\_\_ Ft. from E. Line

990 Ft. from W. Line


Butler

Location \_\_\_\_\_

Rig up \_\_\_\_\_

Drilling and Remarks:

Reported

Well No. 1

### RECORD

Cased \_\_\_\_\_ in., \_\_\_\_\_ ft.

Sand \_\_\_\_\_

Gas \_\_\_\_\_

Oil \_\_\_\_\_

Total Depth \_\_\_\_\_

### PRODUCTION

1st 24 hrs. Nat. \_\_\_\_\_

1st 24 hrs. after shot \_\_\_\_\_

Gas \_\_\_\_\_ Cu. Ft.

Dry Hole \_\_\_\_\_

Abandoned \_\_\_\_\_

Date

SEP 29 1954 19

# FABEN GILSTRAP

Scout

County Butler State Kansas

Sec. 14 (Blk. Twp.) 29 (Sur. Rge.) 3E Map No.

Operator Chas. E. Gould

Well No. 2 Farm Tory

Elev. \_\_\_\_\_ Location NE NW NW

0							

330 Ft. From N Line NW

900 Ft. From W Line Quarter

1st. Report SEP 8 1954

Completion \_\_\_\_\_

Remarks \_\_\_\_\_

Salina Drlg. - Contr.

Spudding Date \_\_\_\_\_

Drlg. Data Wildcat

Location

FABEN GILSTRAP

