KANSAS
Form 51—5M—7-39—Palace


Barton

Section 27 Township 16 Range 11-W

Well No. #1 Burmeister

Company Gore & Finston

Prusa Pool

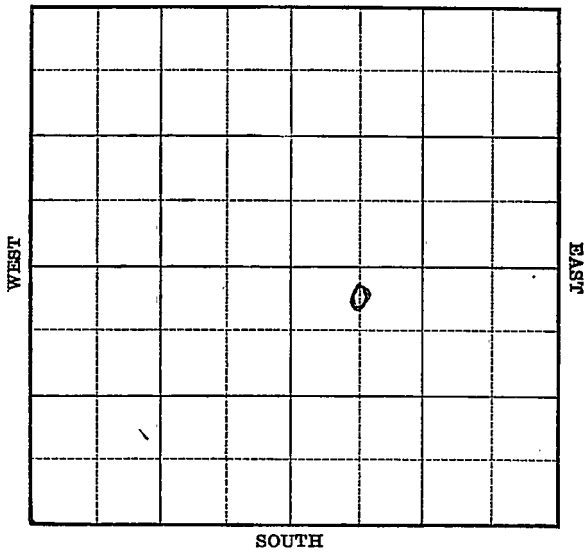

FORM 252-A 5M KANSAS Barton

Sec. 27 Twp. 16 R. 11-W

Well No. #1 Burmeister Farm

Gore & Finston Company


(Prusa)

330 Ft. from N. Line

_____ Ft. from S. Line

_____ Ft. from E. Line

660 Ft. from W. Line

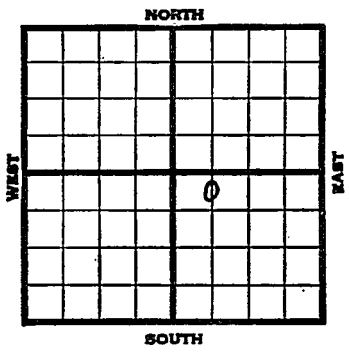

Elev. 1933

1940	REPORT
3/13	Cable.
3/21	Rigging up.
3/28	12" - 400'
	Drlg. 585'
4/4	10" - 640' Anhy 750'
	Drlg. 1275'
4/12	2240' fishing.
4/18	8" - 2438' Drlg. 2515'
4/25	Topeka 2648' 8" - 2728'
	Drlg. 2740'
5/2	S.S.O. 3002' Lans. 3075'
	7" - 3123' Drlg. 3165'
5/9	Arb. 3386' SD 3420' 3415'
5/16	5" - 3391'
	T.D. 3415' (Corrected)

OVER

1940
5/22 Arb. 3386'
5" - 3391'
T.D. 3420'
12 bbls. oil & 15 bbls. water.

ABANDONED

Form 26—200 Bks.—1-40—Palace Barton KANSAS

Map No. 55 Sec. 27 Twp. 16 R. 11W

Well No. 1 Burmeister

Gore & Finston Company

Contractor

FIRST REPORT

C N L NW SE

330 Ft. from N. Line


Ft. from S. Line

Ft. from E. Line

660 Ft. from W. Line

PRUSA POOL

SECTION PLAT

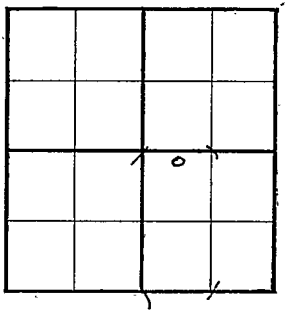

Location

Rig up

Drilling and Remarks:

Cable

RECORD

Cased in., ft.

Sand

Gas

Oil

Total Depth

PRODUCTION

1st 24 hrs. Nat.

1st 24 hrs. after shot

Gas Cu. Ft.

Dry Hole

Abandoned

Date

MAR 13 1940 19

S. J. LEWIS Scout

Form 26—200 Bks.—1-40—Palace Barton KANSAS

Map No. 55 Sec. 27 Twp. 16 R. 11W

Well No. 1 Burmeister

Gore & Finston Company

Contractor

ABANDONED

C N L NW SE

330 Ft. from N. Line


Ft. from S. Line

Ft. from E. Line

660 Ft. from W. Line

PRUSA POOL

SECTION PLAT

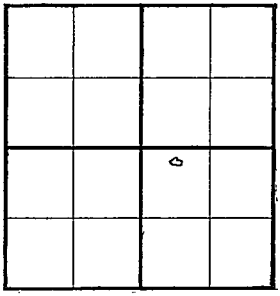

Location

Rig up

Drilling and Remarks:

Cr # 8386

5" @ 3391

12 Hrs & 15 Hr water test

RECORD

Cased in., ft.

Sand

Gas

Oil

Total Depth 3420

PRODUCTION

1st 24 hrs. Nat.

1st 24 hrs. after shot

Gas Cu. Ft.

Dry Hole

Abandoned

Date

MAY 22 1940 19

S. J. LEWIS Scout