

KANSAS

FORM 51 5M 4-41 PETROL

Butler

Section 14 Township 29 Range 3-E


Well No. 1 Falk

Company Plymate & Bornholdt

NORTH

Douglas Pool

WEST

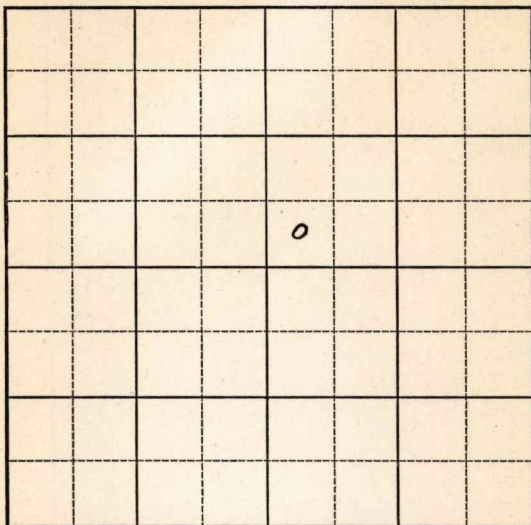


EAST

SOUTH

KANSAS

Butler

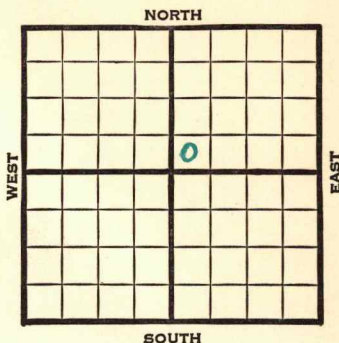Sec. 14 Twp. 29 R. 3-EWell No. #1 Falk FarmPlymate & Bornholdt Company
(Douglas) Ft. from N. Line330 Ft. from S. Line Ft. from E. Line330 Ft. from W. Line**Elev. 1236**

	REPORT
194	
5/7	Spud - Rigging up.
5/15	Shut down.
5/22	" "
5/28	" "
6/5	" "
6/12	" "
6/19	15" - 90' Drlg. 400'
6/26	12" - 605' Drlg. 1280'
7/3	SD 1280'
7/10	"
7/17	"
7/24	Drlg. 1565'
7/31	1565' SD.
8/7	" "
8/15	" "
8/21	" "
8/28	10" - 1454' Lans. 1880'
	Drlg. 1947'
9/4	K.C. 2230' 8" - 2415'
	Drlg. 2500'
	OVER

1941
9/10

Miss. 2740'

T.D. 2800'

No shows.

ABANDONED

Map No. 12 Sec. 14 Twp. 29 R. 3EWell No. 1 FalkPlymate & Bornholdt CompanyFIRST REPORT

Contractor

SW NE

 Ft. from N. Line330 Ft. from S. Line Ft. from E. Line330 Ft. from W. Line

SECTION PLAT

DOUGLAS POOL

Location Rig up

Drilling and Remarks:

Spud

Rigging up

RECORD

Cased in., ft.Sand Gas Oil Total Depth

PRODUCTION

1st 24 hrs. Nat. 1st 24 hrs. after shot Gas Cu. Ft.Dry Hole Abandoned

Date

MAY 7 1941

19

S. J. LEWIS

Scout

KANSAS

Map No. 12 Sec. 14 Twp. 29 R. 3EWell No. 1 FalkPlymate & Bornholdt CompanyContractor

ABANDONED

SECTION PLAT

SW NE

 Ft. from N. Line330 Ft. from S. Line Ft. from E. Line330 Ft. from W. Line

DOUGLAS POOL

Location Rig up

Drilling and Remarks:

*Miss 2740**No show*

RECORD

Cased in., ft.Sand Gas Oil Total Depth 2800

PRODUCTION

1st 24 hrs. Nat. 1st 24 hrs. after shot Gas Cu. Ft.Dry Hole Abandoned

Date

SEP 10 1941 19S. J. LEWIS Scout