KANSAS


FORM 51 5M 4-41 PETROL

Barton

Section 27 Township 16 Range 11-W

Well No. 2 Burmeister

Company Hinkle Drilling

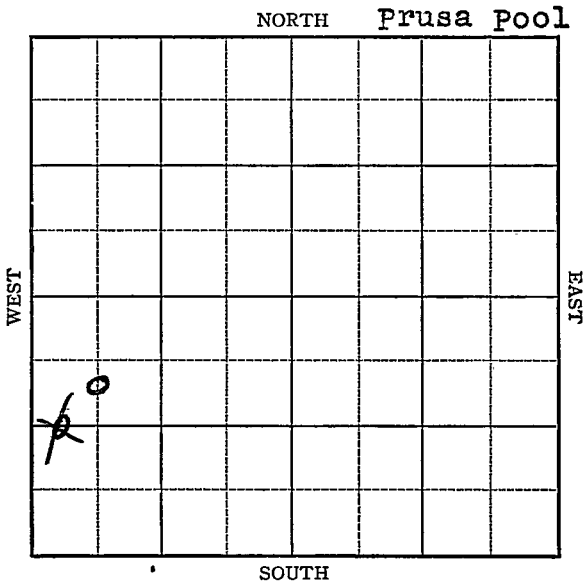

FORM 252-A 5M 6-41 PETROL KANSAS Barton

Sec. 27 Twp. 16 R. 11-W

Well No. #2 Burmeister Farm

Hinkle Drilling Company

(Prusa)


~~1320~~ 990 Ft. from N. Line

_____ Ft. from S. Line

_____ Ft. from E. Line

660 ~~330~~ Ft. from W. Line

Elev. 1933

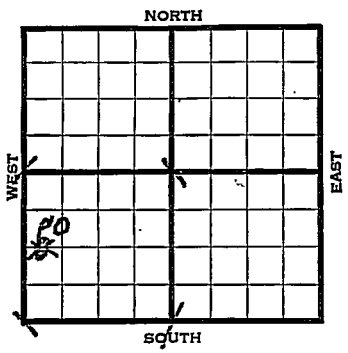

1941	REPORT
8/20	10" - 103' Anhy. 740'
	Drlg. 2260'
8/28	Lans. 3066' Cong. 3358'
	Drlg. 3386'
9/3	Arb. 3395'
	T.D. 3399'
	Water.
	ABANDONED

Form 26—200 Bks.—1-40—Palace Barton KANSAS

Map No. 55 Sec. 27 Twp. 16 R. 11W

Well No. 2 Burmeister

Hinkle Drilling Company

FIRST REPORT Contractor

C W L SW

1320 Ft. from N. Line


_____ Ft. from S. Line

_____ Ft. from E. Line

330 Ft. from W. Line

PRUSA POOL

SECTION PLAT

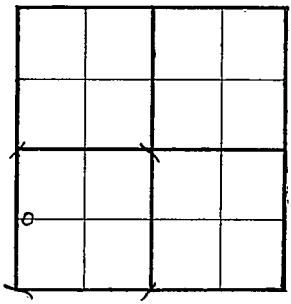

Location _____

Rig up _____

Drilling and Remarks:

10" - 103

Anhy. 740

Drlg. 2260

RECORD

Cased _____ in., _____ ft.

Sand _____

Gas _____

Oil _____

Total Depth _____

PRODUCTION

1st 24 hrs. Nat. _____

1st 24 hrs. after shot _____

Gas _____ Cu. Ft.

Dry Hole _____

Abandoned _____

Date

AUG 20 1941

S. J. LEWIS Scout

Form 26—200 Bks.—1-40—Palace Barton KANSAS

Map No. Sec. 27 Twp. 16 R. 11W

Well No. 2 Burmeister

Hinkle Drilling Company

CORRECTION Contractor

C S L NW SW

990 Ft. from N. Line


Ft. from S. Line

Ft. from E. Line

660 Ft. from W. Line

PRUSA POOL

SECTION PLAT

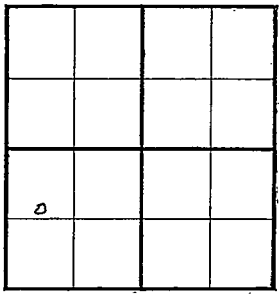

Location

Rig up

Drilling and Remarks:

Reported in

C W L SW

RECORD

Cased in., ft.

Sand

Gas

Oil

Total Depth

PRODUCTION

1st 24 hrs. Nat.

1st 24 hrs. after shot

Gas Cu. Ft.

Dry Hole

Abandoned

Date

AUG 26 1941 19

S. J. LEWIS Scout

Form 26 200 Bks. 5-41 McW. Barton KANSAS

Map No. _____ Sec. 27 Twp. 16 R. 11W

Well No. 2 Burmeister

Hinkle Drilling Company

ABANDONED Contractor

C S L NW SW

990 Ft. from N. Line


_____ Ft. from S. Line

_____ Ft. from E. Line

660 Ft. from W. Line

PRUSA POOL

SECTION PLAT

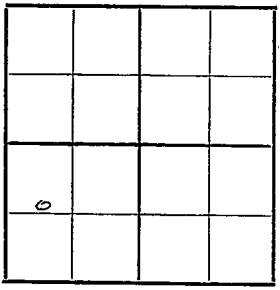

Location _____

Rig up _____

Drilling and Remarks:

At 3395
Water.

RECORD

Cased _____ in., _____ ft.

Sand _____

Gas _____

Oil _____

Total Depth 3399

PRODUCTION

1st 24 hrs. Nat. _____

1st 24 hrs. after shot _____

Gas _____ Cu. Ft.

Dry Hole _____

Abandoned _____

Date

SEP 3 1941 19

S. J. LEWIS Scout