

KANSAS


Barton

FORM 51 5M PETROL

Section 27 Township 16 Range 11-W

Well No. #3 Burmeister

Company Hinkle & Gulf

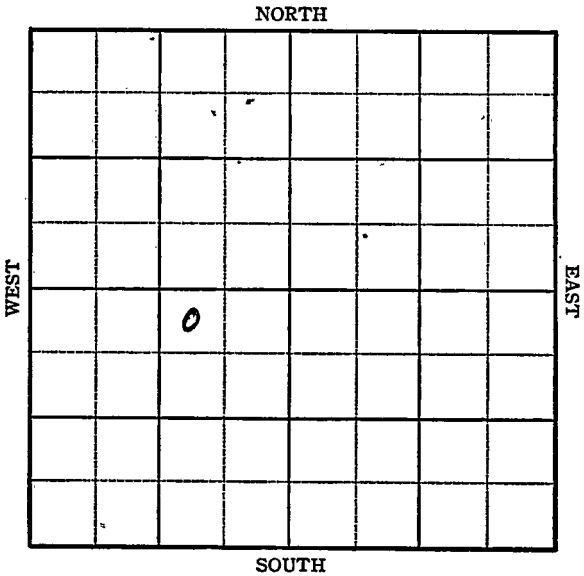

Sec. 27 Twp. 16 R. 11W

Well No. #3 Burmeister Farm

Hinkle and Gulf Company


Kraft-Prusa

330 Ft. from N. Line

\_\_\_\_\_ Ft. from S. Line

990 Ft. from E. Line

\_\_\_\_\_ Ft. from W. Line

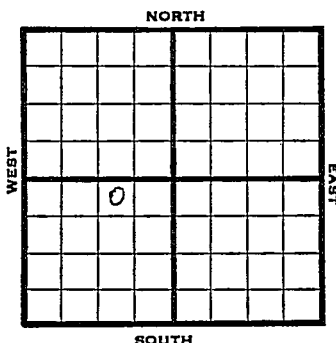

NW NE SW

1945	Elev. 1931	REPORT
12/28	SH	
1946		
1/10	10" - 105'	Anhy 510'
	Lans. 3098'	Drlg. 3242'
1/17	Arb. 3363'	5" - 3364' T.D. 3370'
	Swab 20 oil	per 16 hours.
1/24	" "	"
1/31	" "	"
2/6	" "	"
2/13	Arb. 3363	
	5" @ 3364	
	Echo Pot. 1782	
	TD 3370'	
	Grav. 42.0	
COMPLETED		

**KANSAS** Kansas Pool Name Kraft-Prusa  
 Map No. K-66 Sec. 27 Twp. 16 R. 11W

Well No. 3 Burmeister

Hinkle and Gulf Company

**FIRST REPORT**

Contractor

LN NE SW

**SECTION PLAT**

330 Ft. from N. Line

\_\_\_\_\_ Ft. from S. Line

990 Ft. from E. Line

\_\_\_\_\_ Ft. from W. Line

	o		r

Barton County

Location \_\_\_\_\_

Rig up \_\_\_\_\_

Drilling and Remarks:

SH

**RECORD**

Cased \_\_\_\_\_ in., \_\_\_\_\_ ft.

Sand \_\_\_\_\_

Gas \_\_\_\_\_

Oil \_\_\_\_\_

Total Depth \_\_\_\_\_

**PRODUCTION**

1st 24 hrs. Nat. \_\_\_\_\_

1st 24 hrs. after shot \_\_\_\_\_

Gas \_\_\_\_\_ Cu. Ft.

Dry Hole \_\_\_\_\_

Abandoned \_\_\_\_\_

Date

DEC 28 1945 19

S. J. LEWIS Scout

**KANSAS** Kansas Pool Name Kraft-Prusa  
 Map No. 55 Sec. 27 Twp. 16 R. 11W

Well No. 3 Burmeister

Hinkle and Gulf Company

**COMPLETED**

NW NE SW

Contractor  
E. I. 1931.  
**SECTION PLAT**

330 Ft. from N. Line

\_\_\_\_\_ Ft. from S. Line

990 Ft. from E. Line

\_\_\_\_\_ Ft. from W. Line

	o		

**Barton County**

Location \_\_\_\_\_

Rig up \_\_\_\_\_

Drilling and Remarks:

*Cor 3363*  
*5" 3364*  
*Echd P 1782*

*42 34*

**RECORD**

Cased \_\_\_\_\_ in., \_\_\_\_\_ ft.

Sand \_\_\_\_\_

Gas \_\_\_\_\_

Oil \_\_\_\_\_

Total Depth 3370

**PRODUCTION**

1st 24 hrs. Nat. \_\_\_\_\_

1st 24 hrs. after shot \_\_\_\_\_

Gas \_\_\_\_\_ Cu. Ft.

• Dry Hole \_\_\_\_\_

Abandoned \_\_\_\_\_

Date

FEB 13 1946 19

S. J. LEWIS Scout