

KANSAS


Barton

Section 27 Township 16 Range 11W

Well No. #3 Lena

Company Hinkle et al.

NORTH

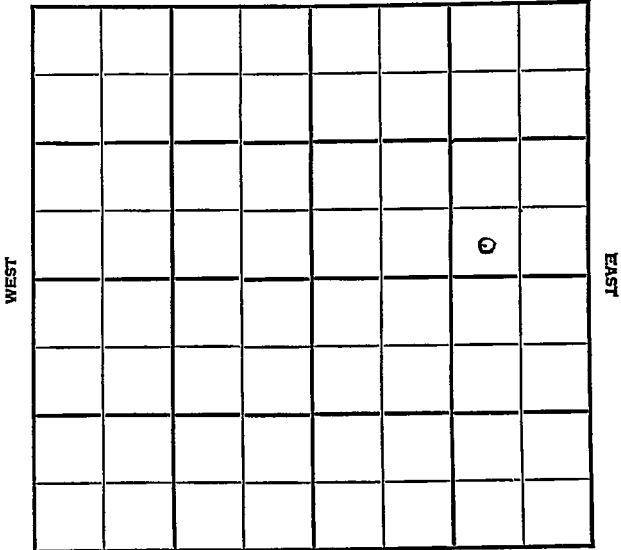

SOUTH

KANSAS

Barton ✓

Sec. 27 Twp. 16 R. 11W

Well No. #3 Lena Farm

Hinkle et al Company

Kraft-Prusa Pool


 Ft. from N. Line

330' Ft. from S. Line

990' Ft. from E. Line

 Ft. from W. Line

SW SE NE

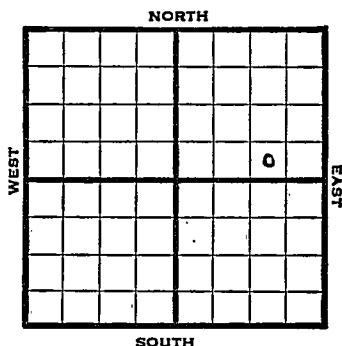

1948

Elev. 1927' REPORT

2/4 Surface Hole

2/11 8" @ 317'
Drlg. 2865'

2/18 Lans. 3090'
Cong. 3367'
3445' in Cong.
TD 3445'
Abd.

ABANDONED

Map No. _____ Sec. 27 Twp. 16 R. 11W

Well No. 3 Lena

Hinkle etal. Company

FIRST REPORT

Contractor

SW SE NE

SECTION PLAT

_____ Ft. from N. Line

330 Ft. from S. Line

990 Ft. from E. Line

_____ Ft. from W. Line

			a

Barton County

Location _____

Rig up _____

Drilling and Remarks:

surface hole

RECORD

Cased _____ in., _____ ft.

Sand _____

Gas _____

Oil _____

Total Depth _____

PRODUCTION

1st 24 hrs. Nat. _____

1st 24 hrs. after shot _____

Gas _____ Cu. Ft.

Dry Hole _____

Abandoned _____

Date

FEB 4 1948 19

S. J. LEWIS Scout

Kansas


Map No. K-55 Sec. 27 Twp. 16 R. 11WWell No. 3 LenaHinkle et al.

Company

ABANDONED

Contractor

SW SE NE

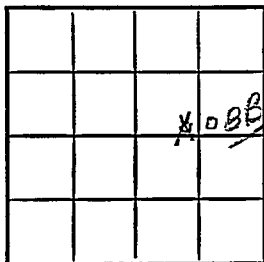E 1192?
SECTION PLAT Ft. from N. Line330 Ft. from S. Line990 Ft. from E. Line Ft. from W. LineBarton CountyLocation Rig up

Drilling and Remarks:

Loma 3090
Cong 3364
3445 in Cong

RECORDCased in., ft.Sand Gas Oil Total Depth 3445**PRODUCTION**1st 24 hrs. Nat. 1st 24 hrs. after shot Gas Cu. Ft.Dry Hole Abandoned

Date

FEB 18 194819S. J. LEWIS

Scout