FORM 51 5M 6-46 PETROL


KANSAS

Barton county

Section 27 Township 16 Range 11-W

Well No. #5, Wellenberg

Company Hinkle and Gulf

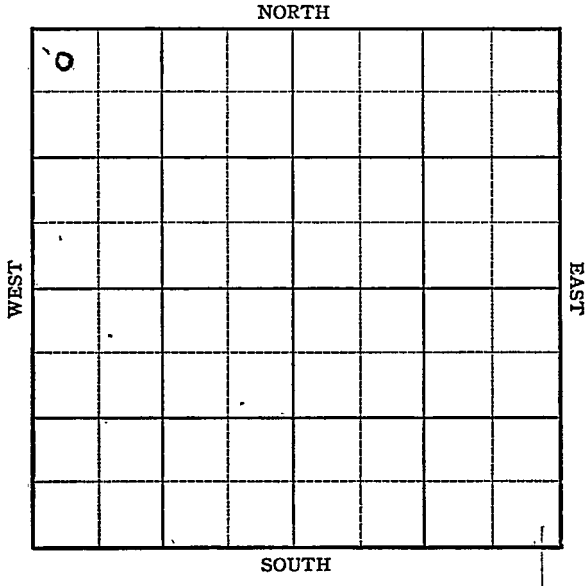

FORM 252-A
5M 6-46 PETROL KANSAS Barton county ✓

Sec. 27 Twp. 16 R. 11-W

Well No. #5, Wellenberg Farm

Hinkle and Gulf Company

Kraft-Prusa


330' Ft. from N. Line

Ft. from S. Line

Ft. from E. Line

330' Ft. from W. Line

NW/C

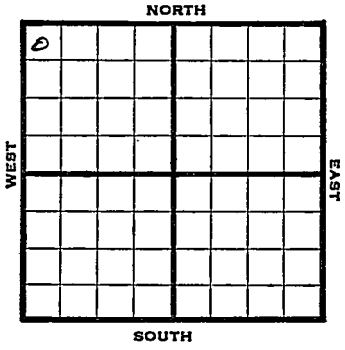

1946	1927 REPORT
10/2	Location
10/8	10" @ 116' Drlg 2431'
10/15	Arb 3340-45 TD 5" @ 3341 RUST
10/22	Lans 3058' 2600' oil 1½ hrs.
10/29	" " "
11/6	" " "
11/12	1000 acid
11/20	"
11/27	"
12/4	Arb 3340' 5" @ 3341' TD 3345' 1000 Acid Echo POt 8564' Max 3000 42 Grav.

COMPLETED

FORM 26 200 BKS 2-44 PETROL

KANSAS Kansas Pool Name Kraft-Prusa

Map No. 55 Sec. 27 Twp. 16 R. 11W


Well No. 5 Wellenberg

Hinkle & Gulf Company

FIRST REPORT Contractor

NW/C

SECTION PLAT

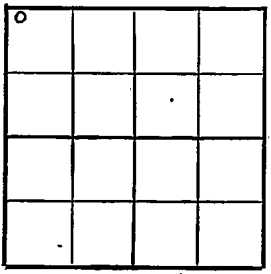

330 Ft. from N. Line

Ft. from S. Line

Ft. from E. Line

330 Ft. from W. Line

Barton County

Location X

Rig up

Drilling and Remarks:

RECORD

Cased in., ft.

Sand

Gas

Oil

Total Depth

PRODUCTION

1st 24 hrs. Nat.

1st 24 hrs. after shot

Gas Cu. Ft.

Dry Hole

Abandoned

Date

OCT 2 1946 19

S. J. LEWIS Scout

KANSAS

Form 26 200 Bks. 10-46 Petrol Kansas

Kraft-Prusa

Map No. J J Sec. 27 Twp. 16 R. 11W

Well No. 5 Willenberg


Hinkle & Gulf Company

COMPLETED Contractor

NW/C

E1, 1927

SECTION PLAT

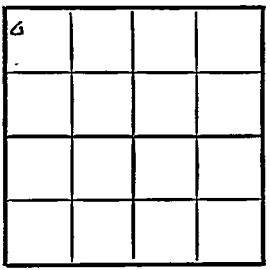

330 Ft. from N. Line

Ft. from S. Line

Ft. from E. Line

330 Ft. from W. Line

Barton County

Location

Rig up

Drilling and Remarks:

Cer #3348

5" @ 3341

1500 acid C

Echo #2 #3364

Max 3000

43° Gr

RECORD

Cased in., ft.

Sand

Gas

Oil

Total Depth 3345

PRODUCTION

1st 24 hrs. Nat.

1st 24 hrs. after shot

Gas Cu. Ft.

Dry Hole

Abandoned

Date

DEC 4 1946 19

S. J. LEWIS Scout