

KANSAS

Barton County

FORM 51 5M PETROL

Section 27 Township 16 Range 11W

Well No. 3 Willenberg

Company Hinkle & Gulf

NORTH

0							

SOUTH

WEST EAST

KANSAS

Barton

Sec. 27 Twp. 16 R. 11-NWell No. #3 Willenberg FarmHinkle & Gulf Company

Kraft-Prusa


990 Ft. from N. Line

Ft. from S. Line

Ft. from E. Line

330 Ft. from W. Line

SW NW NW Elev. 1919

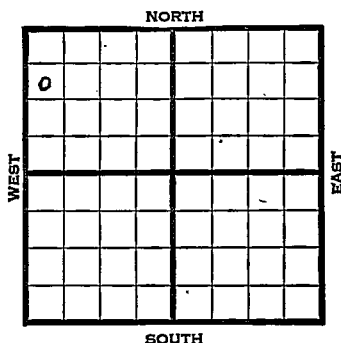

1945

REPORT

7/3 Location

7/11 RUR

7/19 10" @ 115

Anhy 740

Drlg. 1569

7/26 Drlg. 2830

8/1 Lans 3058

Perf. 3353-3356

TD 3356

5" @ 3353 RUST

8/8 3100' oil 12 hrs.

8/15 " " #

8/22 Pump 11 oil per hr.

8/29 " " " "

9/5 " " " "

9/12 Arb. 3353

5" @ 3353

500 acid.

TD 3356

Depth Pot. 971

Grav. 42.7

COMPLETED

KANSAS Pool Name Kraft-PrusaMap No. 55 Sec. 27 Twp. 16 R. 11WWell No. 3 WillenbergHinkle & Gulf

Company

FIRST REPORT

Contractor

SW NW NW

SECTION PLAT

o			

990 Ft. from N. Line Ft. from S. Line Ft. from E. Line330 Ft. from W. LineBarton CountyLocation XRig up

Drilling and Remarks:

RECORD

Cased in., ft.Sand Gas Oil Total Depth

PRODUCTION

1st 24 hrs. Nat. 1st 24 hrs. after shot Gas Cu. Ft.Dry Hole Abandoned

Date

JUL 3 1945 19S. J. LEWIS Scout

Kraft-Prusa

Kansas Pool Name

KANSAS
Map No. 55

Sec. 27

Twp. 16

R. 11W

Well No. 3 Willenberg

Hinkle & Gulf

Company

COMPLETED

Contractor

SW NW NW


SECTION PLAT

990 Ft. from N. Line

Ft. from S. Line

Ft. from E. Line

330 Ft. from W. Line

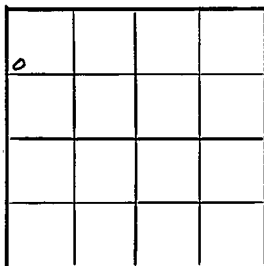

Barton County

Location

Rig up

Drilling and Remarks:

Per 83353

5" 83353


Sept 12 1945

42 2/3

RECORD

Cased in., ft.

Sand

Gas

Oil

Total Depth 3256

PRODUCTION

1st 24 hrs. Nat.

1st 24 hrs. after shot

Gas Cu. Ft.

Dry Hole

Abandoned

Date

SEP 12 1945

19

S. J. LEWIS Scout