


Barton

FORM 51 IOM 12-46 PETROL

Section 27 Township 16 Range 11W

Well No. 7 Willenberg

Company Hinkle & Gulf

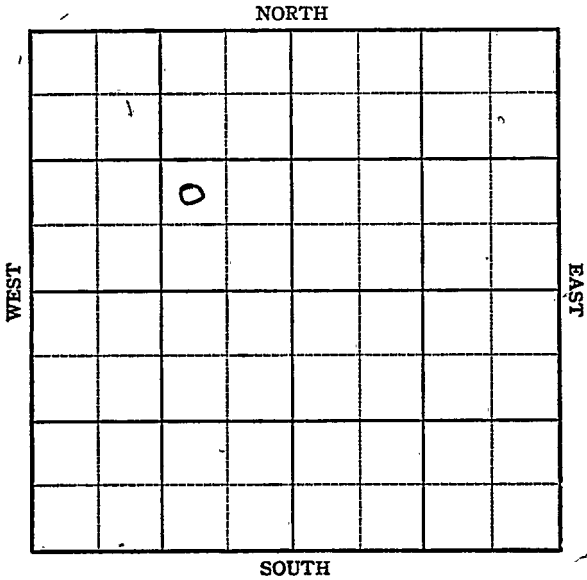

KANSAS

Barton county

Sec. 27 Twp. 16 R. 11W

Well No. 7 Willenberg Farm

Hinkle & Gulf Company

Kraft-Prusa


Ft. from N. Line

990 Ft. from S. Line

990 Ft. from E. Line

Ft. from W. Line

NW SE NW

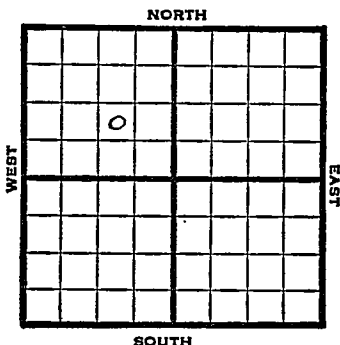

1947 Elev. 1927' REPORT

5/28	Location
6/3	RUR
6/10	"
6/17	Drlg 1300'
6/24	Arbuckle 3358-65 TD 5" @ 3359' EUST
7/1	" " " "
7/8	" " " "
7/16	Arbuckle 3358' 5" @ 3359' Echo Pot 2751' Gr. 42 T.D. 3365' Complete

COMPLETED

Map No. _____ Sec. 27 Twp. 16 R. 11W

Well No. 7 Willenberg

Hinkle & Gulf Company

FIRST REPORT Contractor

NW SE NW

SECTION PLAT

	o		
		*	

_____ Ft. from N. Line

990 Ft. from S. Line

990 Ft. from E. Line

_____ Ft. from W. Line

Barton County

Location X

Rig up _____

Drilling and Remarks: _____

RECORD

Cased _____ in., _____ ft.

Sand _____

Gas _____

Oil _____

Total Depth _____

PRODUCTION

1st 24 hrs. Nat. _____

1st 24 hrs. after shot _____

Gas _____ Cu. Ft.

Dry Hole _____

Abandoned _____

Date

MAY 28 1947 19 S. J. LEWIS Scout

Map No. 55 Sec. 27 Twp. 16 R. 11W

Well No. 7 Willenberg

Hinkle & Gulf Company

COMPLETE

Contractor

NW SE NW

E 11927
SECTION PLAT

	6		

 Ft. from N. Line

990 Ft. from S. Line

990 Ft. from E. Line

 Ft. from W. Line

Barton County

Location

Rig up

Drilling and Remarks:

Cery 3308

5" C 3309

Echid 2751

42 1/2

RECORD

Cased in., ft.

Sand

Gas

Oil

Total Depth 2865

PRODUCTION

1st 24 hrs. Nat.

1st 24 hrs. after shot

Gas Cu. Ft.

Dry Hole

Abandoned

Date

JUL 16 1947

19

S. J. LEWIS

Scout