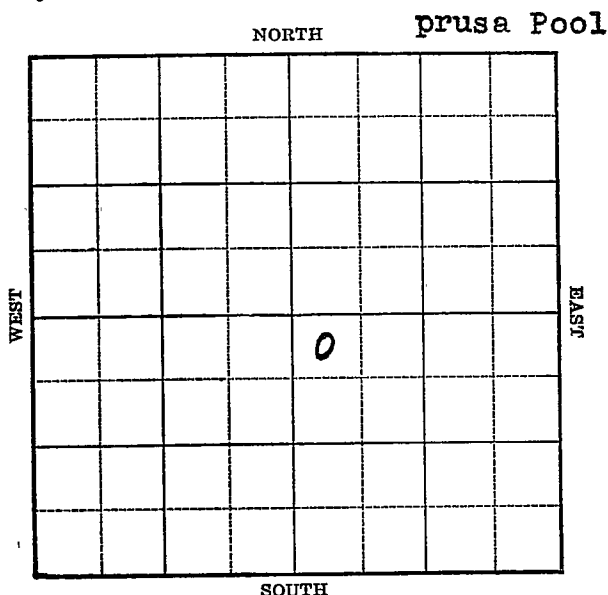


Section 28 Township 16 Range 11-WWell No. #1 EsfieldCompany B. B. & M. Drlg.

KANSAS


Barton

Sec. 28 Twp. 16 R. 11-WWell No. #1 Esfield FarmB. B. & M Drig. Company

(Prusa)

330 Ft. from N. Line       Ft. from S. Line       Ft. from E. Line330 Ft. from W. Line

Elev. 1921

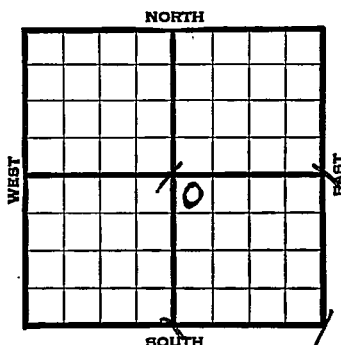

| 1939 | REPORT                           |
|------|----------------------------------|
| 5/31 | R.U.C.T.                         |
| 6/8  | 15" @ 370' Drig. 600'            |
| 6/16 | Anhy 754' 10" - 754'             |
|      | Drig. 1430'                      |
| 6/23 | 8" - 2086' Drig. 2435'           |
| 6/29 | 8" - 2428' Topeka 2635'          |
|      | Drig. 2720'                      |
| 7/6  | Lans. 3055' 6" - 3042'           |
|      | T.D. 3056' U.R. 6".              |
| 7/13 | Arb. 3334' 5" - 3337'            |
|      | T.D. 3345' H.F.O. 6 hrs.         |
| 7/19 | Arb. 3334'                       |
|      | 5" - 3337'                       |
|      | T.D. 3345'                       |
|      | Depthograph potential 5189 bbls. |
|      | Maximum 2750 bbls.               |
|      | COMPLETED                        |

Map No. 55 Sec. 28 Twp. 16 R. 11WWell No. 1 EsfieldB B & M Drlg.


Company

Contractor

~~FIRST REPORT~~

## SECTION PLAT

NW SE

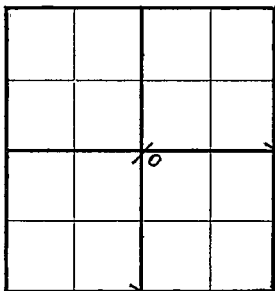330 Ft. from N. Line       Ft. from S. Line       Ft. from E. Line330 Ft. from W. Line

PRUSA POOL

Location                                 Rig up                                 

Drilling and Remarks:

RUCT

## RECORD

Cased            in.,            ft.Sand                                 Gas                                 Oil                                 Total Depth                                 

## PRODUCTION

1st 24 hrs. Nat.                                 1st 24 hrs. after shot                                 Gas                                  Cu. Ft.Dry Hole                                 Abandoned                                 

Date

MAY 31 1939

19

S. J. LEWIS

Scout

Map No. 55 Sec. 28 Twp. 16 R. 11WWell No. 1 Esfield


B B &amp; M Drlg.

Company

Contractor

COMPLETED  
NW SE

SECTION PLAT

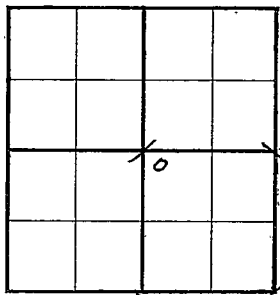330 Ft. from N. Line

\_\_\_\_\_ Ft. from S. Line

\_\_\_\_\_ Ft. from E. Line

330 Ft. from W. Line

PRUSA POOL

Location \_\_\_\_\_

Rig up \_\_\_\_\_

Drilling and Remarks:

*Car 3334**5" @ 3337**Depthograph 28*  
*5-189**Maximum*  
*2750*

## RECORD

Cased \_\_\_\_\_ in., \_\_\_\_\_ ft.

Sand \_\_\_\_\_

Gas \_\_\_\_\_

Oil \_\_\_\_\_

Total Depth 3345

## PRODUCTION

1st 24 hrs. Nat. \_\_\_\_\_

1st 24 hrs. after shot \_\_\_\_\_

Gas \_\_\_\_\_ Cu. Ft.

Dry Hole \_\_\_\_\_

Abandoned \_\_\_\_\_

Date

JUL 19 1939 19

S. J. LEWIS

Scout