
FORM 51 5M 6-46 PETRO KANSAS

Barton county

Section 28 Township 16 Range 11 W

Well No. #3, Esfeld

Company Stanolind Oil and Gas Company

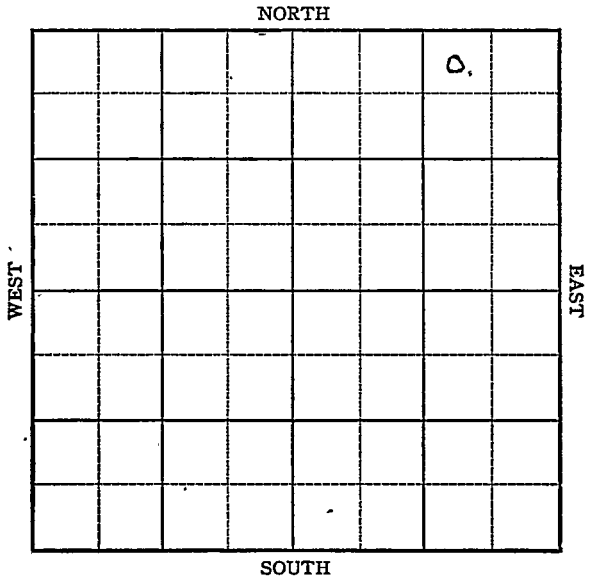

FORM 252-A
5M 6-46 PETROL KANSAS Barton county

Sec. 28 Twp. 16 R. 11-W

Well No. #3, Esfeld Farm

Stanolind Oil and Gas Company Company

Kraft-Prusa


330' Ft. from N. Line

Ft. from S. Line

990' Ft. from E. Line

Ft. from W. Line

NW NE NE

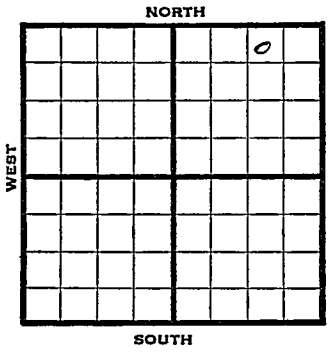

1946	1906 REPORT
10/2	Anhy. 730'; 8" @ 739'; 1585'.
10/8	Lans 3042' Drlg 3082'
10/15	Drlg 3234'
10/22	Arb 3328 5" @ 3329' TD 3335' 500 acid
10/30	Arb 3328' 5" @ 3329' TD 3335' 500 Acid Pump 300 POT 42 Grav.

COMPLETED

FORM 26 200 BKS 2-44 PETROL

KANSAS Kansas Pool Name Kraft-Prusa

Map No. 5 J Sec. 28 Twp. 16 R. 11W


Well No. 3 Esfeld

Stanolind Company

FIRST REPORT Contractor

NW NE NE

SECTION PLAT

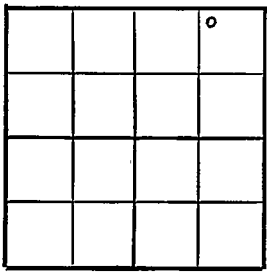

330 Ft. from N. Line

Ft. from S. Line

990 Ft. from E. Line

Ft. from W. Line

Barton County

Location

Rig up

Drilling and Remarks:

Anhy 730'
8" @ 739'
1585'

RECORD

Cased in., ft.

Sand

Gas

Oil

Total Depth

PRODUCTION

1st 24 hrs. Nat.

1st 24 hrs. after shot

Gas Cu. Ft.

Dry Hole

Abandoned

Date

OCT 2 1946 19 S. J. LEWIS Scout

Kraft-Prusa

Form 26 200 Bks. 10-46 Petrol

Kansas

Map No.)) Sec. 28 Twp. 16 R. 11W

Well No. 3 Esfeld

Stanolind Company


COMPLETED

Contractor

NW NE NE

E1, 1906

SECTION PLAT

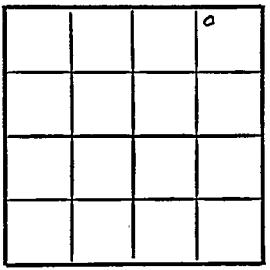

330 Ft. from N. Line

Ft. from S. Line

990 Ft. from E. Line

Ft. from W. Line

Barton County

Location

Rig up

Drilling and Remarks:

Cer @ 3328

5' @ 3329

500 acid

Pump 300 BW

42 46

RECORD

Cased in., ft.

Sand

Gas

Oil

Total Depth 3329

PRODUCTION

1st 24 hrs. Nat.

1st 24 hrs. after shot

Gas Cu. Ft.

Dry Hole

Abandoned

Date

OCT 30 1946 19 S. J. LEWIS Scout