KANSAS


Form 51—5M—11-38—Palace

Barton

Section 28 Township 16 Range 11-W

Well No. #1 Esfeld

Company Sinclair Prairie

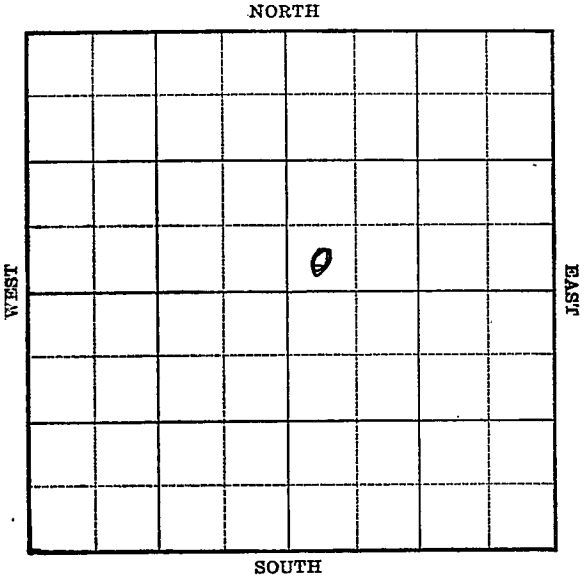

FORM 252-A 5M 4-39 KANSAS Barton

Sec. 28 Twp. 16 R. 11-W

Well No. #1 Esfeld Farm

Sinclair-Prairie Company


(Prusa)

____ Ft. from N. Line

330 Ft. from S. Line

____ Ft. from E. Line

330 Ft. from W. Line

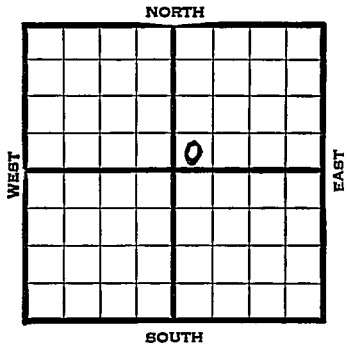

Elev. 1912

1939	REPORT
7/26	10" - 113' WOC.
8/3	Drlg. 2200'
8/10	Arb. 3383' T.D. 3389' S.S.O.
	35' water drill stem test.
	Shut down.
8/16	Lans. 3070'
	Cong. 3373'
	Arb. 3383' Water.
	T.D. 3389'
	ABANDONED

Form 26—1M Bks.—2-29

KANSAS

Barton

Map No. 55 Sec. 28 Twp. 16 R. 11W

Well No. 1 Esfeld


Sinclair Prairie Company

Contractor

FIRST REPORT

SW NE

SECTION PLAT

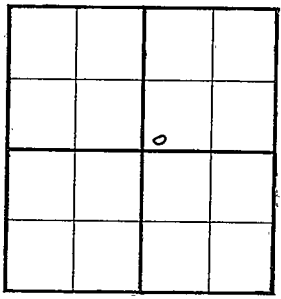

____ Ft. from N. Line

330 Ft. from S. Line

____ Ft. from E. Line

330 Ft. from W. Line

PRUSA POOL

Location ____

Rig up ____

Drilling and Remarks:

10" - 113

WOC

RECORD

Cased ____ in., ____ ft.

Sand ____

Gas ____

Oil ____

Total Depth ____

PRODUCTION

1st 24 hrs. Nat. ____

1st 24 hrs. after shot ____

Gas ____ Cu. Ft.

Dry Hole ____

Abandoned ____

Date

____ 1930 19____

S. J. LEWIS Scout

Form 26—1M Bks.—2-29 Barton KANSAS

Map No. 55 Sec. 28 Twp. 16 R. 11W


Well No. 1 Esfeld

Sinclair Prairie Company

Contractor

ABANDONED
SW NE

SECTION PLAT

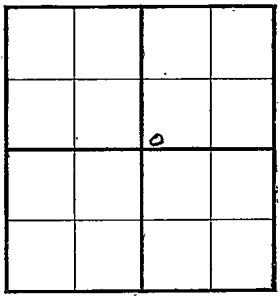

____ Ft. from N. Line

330 Ft. from S. Line

____ Ft. from E. Line

330 Ft. from W. Line

PRUSA POOL

Location

Rig up

Drilling and Remarks:

Lans 3070
Conq. 3373
OH 3383
Water.

RECORD

Cased ____ in., ____ ft.

Sand

Gas

Oil

Total Depth 3389

PRODUCTION

1st 24 hrs. Nat.

1st 24 hrs. after shot

Gas ____ Cu. Ft.

Dry Hole

Abandoned

Date

AUG 16 1939 19____

S. J. LEWIS Scout