
FORM 51 25M 8-50 WESTERN O.W.D.D Barton KANSAS

Section 28 Township 16 Range 11 W

Well No. ~~#9~~ #2 Esfeld

Company N C R A

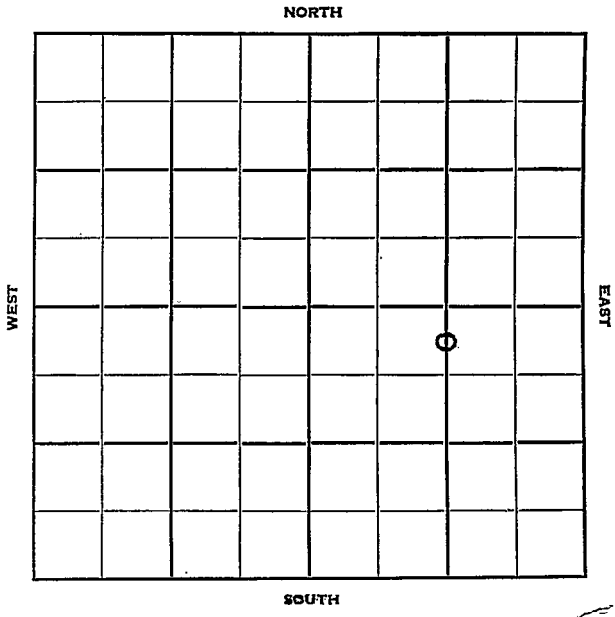

FORM 252-B
10M 11-50 PETROL

O. W. D. D KANSAS

Barton

Sec. 28 Twp. 16 R. 11W

Well No. #2 #9 Esfeld Farm

N C RA Company

Braden Drlg. → Contr. Contractor

Kraft-Prusa Pool


330' Ft. from N. Line

Ft. from S. Line

1320' Ft. from E. Line

Ft. from W. Line

C N L N½ SE

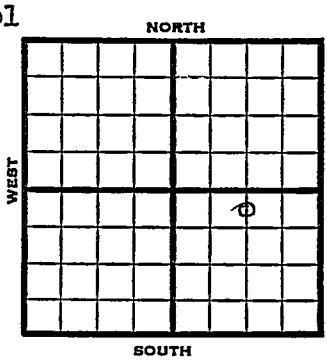

1951	Elv. 1910' REPORT
1/31	RUR
2/14	Spud 1-29-51 D&A TD 3372 8" @ 762' Heeb. 2956' Toronto 2976 Lans. 3066' DST 3245-60 opn 90 min Rec. 25' mud Cong. 3344' Arb. 3368' DST 3358-72 opn 90 min Rec. 450' wtr. D&A ABANDONED
1951	O. W. D. D
10/31	Lans. 3066' Arb. 3368' OTD 3372 was D&A DD 3605' TD 5" @ 3418'
11/7	SWD well TD 3605' Lans. 3066' Arb. 3368' OTD 3372' DD 3605' 5" @ 3418' Comp. for SWD well. ABANDONED

FORM 275 FOR SALE BY KANSAS BLUE PRINT CO.


County Barton State Kansas

Sec. 28 (Blk. Twp.) 16 (Sur. Rge.) 11W Map No.

Operator N C R A

Well No. 9 Farm Esfeld

Elev. Location C N L N½ SE

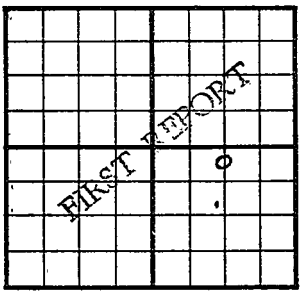

330 Ft. From N Line SE

1320 Ft. From E Line Quarter

1st. Report JAN 31 1951

Completion

Remarks Braden Drlg. - Contr.

Spudding Date

Drlg. Data Kraft-Prusa Pool

R U R

J. E. TYRA

FORM 275 FOR SALE BY KANSAS BLUE PRINT CO.


County Barton State Kansas

Sec. 28 (Blk. Twp.) 16 (Sur. Rge.) 11W Map No.

Operator N C R A

Well No. 9 Farm Esfeld

Elev. 1910 Location C N L N½ SE

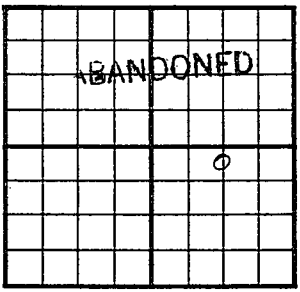

330 Ft. From N Line SE

1320 Ft. From E Line Quarter

1st. Report

Completion FEB 1 4 1951

Remarks Kraft-Prusa Pool

Braden Drlg. - Contr.

Spudding Date 1-29-51

Drlg. Data D & A TD 3372

8" @ 762 Heeb. 2956 Toronto 2976

Lans. 3066 DST 3245-60 open 90 min.

Rec. 25' mud Cong. 3344 Arb. 3368

DST 3368-72 open 90 min. Rec. 450' water

D. & A

J. E. TYRA

FORM 275 FOR SALE BY KANSAS BLUE PRINT CO.


County Barton State Kansas

Sec. 28 (Blk. Twp.) 16 (Sur. Rge.) 11W Map No.

Operator N C R A

Well No. 2 Farm Esfeld SWD well #9

Elev. Location N/2 N/2 SE

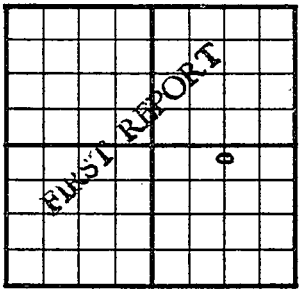

330 Ft. From N Line SE

1320 Ft. From E Line Quarter

1st. Report OCT 31 1951

Completion

Remarks (OWDD) O. W. D. D

Lindas - Contr.

Spudding Date

Drlg. Data Kraft Prusa

Lans 3066 Arb 3368 OTD 3372 was D & A

DD 3605 T.D. 5" @ 3418

J. E. TYRA

FORM 275 FOR SALE BY KANSAS BLUE PRINT CO.


County Barton State Kansas

Sec. 28 (Blk. Twp.) 16 (Sur. Rge.) 11W Map No.

Operator N C R A

Well No. 2 Farm Esfeld (was #9 Esfeld)

Elev. 1910 Location C N L N½ SE

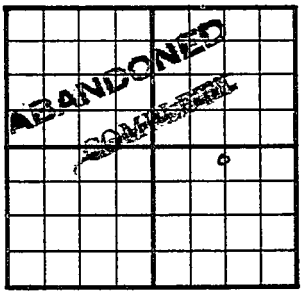

330 Ft. From N Line SE

1320 Ft. From E Line Quarter

1st. Report

Completion NOV 7 1951

Remarks OWDD W. D. D

Lindas - Contr.

Spudding Date

Drlg. Data SWD well TD 3605

Lans. 3066 Arb. 3368 OTD 3372

DD 3605 5" @ 3418 Comp. for SWD well

J. E. TYRA