

KANSAS


FORM 51 IOM 12-46 PETROL

Barton county

Section 28 Township 16 Range 11-W

Well No. #5 Esfeld

Company Stanolind

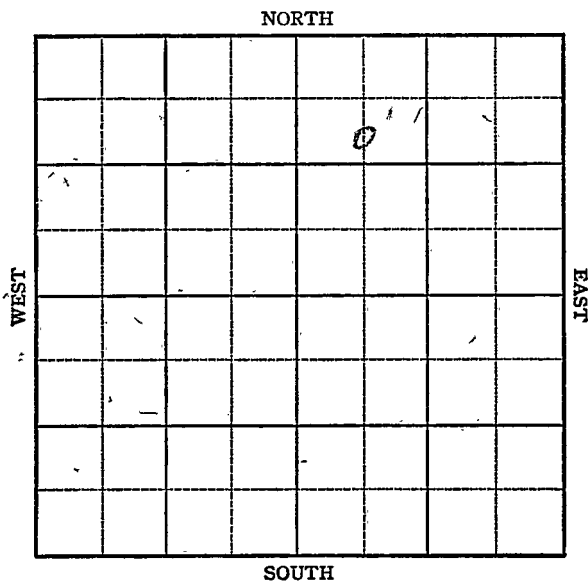

KANSAS

Barton

Sec. 28 Twp. 16 R. 11-W

Well No. #5 Esfeld Farm

Stanolind Company


Kraft-Prusa

990 Ft. from N. Line

Ft. from S. Line

Ft. from E. Line

660 Ft. from W. Line

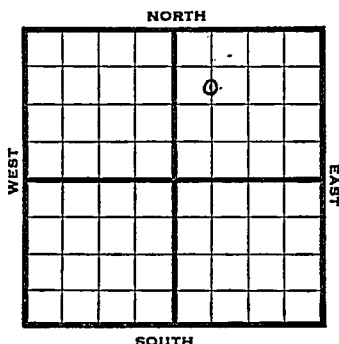

C S L NW NE

1947

1888

REPORT

1/29 Anhy 726
8" @ 733
WOC

2/12 Lans 3026
Arb 3296
TD 3301'
5" @ 3296'
RUST

2/19 Swb 9 bbls oil PH

2/26 " "

3/4 TD 3301'

3/11 TD 3301'

3/26 Art 3296'
5" @ 3296'
500 acid
Dep & Pot. 3000
42.0 Gr.
TD 3301'

COMPLETED

Map No. 55 Sec. 28 Twp. 16 R. 11WWell No. 5 EsfeldStanolind Company**FIRST REPORT** Contractor

C. S L NW NE

SECTION PLAT990 Ft. from N. Line Ft. from S. Line Ft. from E. Line660 Ft. from W. Line

		o	

Barton CountyLocation Rig up

Drilling and Remarks:

Anhy 726

8" @ 733 WOC

RECORDCased in., ft.Sand Gas Oil Total Depth **PRODUCTION**1st 24 hrs. Nat. 1st 24 hrs. after shot Gas Cu. Ft.Dry Hole Abandoned

Date

JAN 29 1947 19 S. J. LEWIS Scout


Kansas

Map No. 155 Sec. 28 Twp. 16 R. 11WWell No. 5 EsfeldStanolind Company

COMPLETE

Contractor

C S L NW NE

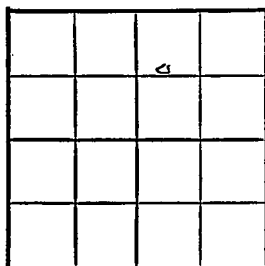E. 1888
SECTION PLAT990 Ft. from N. Line Ft. from S. Line Ft. from E. Line660 Ft. from W. LineBarton CountyLocation Rig up

Drilling and Remarks:

Per 3286
5-103286
500 acid
Dep 10328000

42 2/3

RECORD

Cased in., ft.Sand Gas Oil Total Depth 2301

PRODUCTION

1st 24 hrs. Nat. 1st 24 hrs. after shot Gas Cu. Ft.Dry Hole Abandoned

Date

MAR 26 1947 19

S. J. LEWIS

Scout