

Woodson Co

Map No. 1

Sec. 23

Twp. 26

R. 14

Well No. 3


~~Brookwood~~

Long

(KBS DRL)
Farm

Peardess O & P

Company

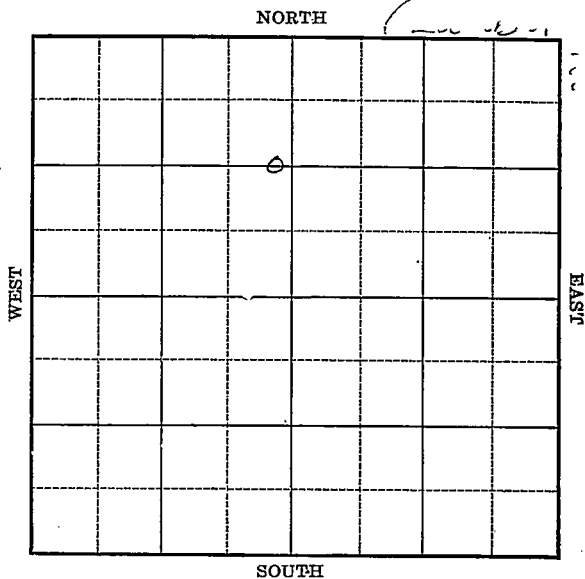

Location _____

Drilling Remarks

Rig Up _____

Drilling Remarks

RECORD

Cased _____ in. _____ ft.

Sand _____

Gas _____

Oil _____

Total Depth _____

PRODUCTION

1st 24 hrs. Nat. _____

1st 24 hrs. after shot _____

Gas _____ cu. ft.

Dry Hole _____

Abandoned _____


Map No. Kans. Sec. 23 Twp. 26 R 14
 Well No. # 3 unknown Louk (K65) (DKL) Farm
Peerless O. G. Company

1320 Ft. from N. Line

_____ Ft. from S. Line

200 Ft. from E. Line

_____ Ft. from W. Line

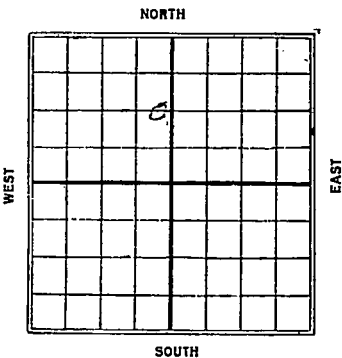

1926.

Date	REPORT
5/19	machine
6/2	—
6/10	same
6/18	—
6/25	—
6/30	—
7/18	—
7/15	—
7/22	—
7/28	—
8/4	—
8/11	—
8/18	—
8/25	—
8-31	—
9/15	—
9/22	—
9/29	same
10/3	—
10/27	—
11/11	—
11/17	—

11/23 - Same

12/8 _____

12/15 _____

12/22 _____

12/30 _____

1927

1/6 _____

1/13 _____

1/19 _____

1/26 _____ machine

2/3 _____

2/10 _____

2/17 _____

2/24 _____

3/2 _____

3/9 _____

3/16 _____

3/24 _____

3/30 _____

4/7 _____

4/13 _____ Machine

4/20 _____

4/27 _____

5/5 - Sand 1220-1295

200/300 bbla

51 gravity 25.1295'

Woodson Co

Map No. KANSAS Sec. 23 Twp. 26 R. 14

Well No. 3 ~~unfractured~~ ^{Low} (K65 DRU)
Perches Oil Co Company

Contractor

FIRST REPORTS

SECTION PLAT

1320 Ft. from N. Line

_____ Ft. from S. Line

206 Ft. from E. Line

_____ Ft. from W. Line

	☉		

Location _____

Rig up Mackin

Drilling and Remarks:

RECORD

Cased _____ in., _____ ft.

Sand _____

Gas _____

Oil _____

Total Depth _____

PRODUCTION

1st 24 hrs. Nat. _____

1st 24 hrs. after shot _____

Gas _____ Cu. Ft.

Dry Hole _____

Abandoned _____

Date

MAY 12 1926

192

CHAS. L. SHERWOOD
 Scout

Woodson

Map No. KANSAS Sec. 23 Twp. 26 R. 14
Well No. 3 Hubert bank (K65)
Leekless Oil Company (DRL)

Contractor

COMPLETED

SECTION PLAT

1320 Ft. from N. Line
_____ Ft. from S. Line
200 Ft. from E. Line
_____ Ft. from W. Line

Location _____

Rig up _____

Drilling and Remarks:

200 300 Bl.
21 Gravity

RECORD

Cased _____ in., _____ ft.
Sand 1220-1295
Gas _____
Oil _____
Total Depth 1295

PRODUCTION

1st 24 hrs. Nat. _____
1st 24 hrs. after shot _____
Gas _____ Cu. Ft.
Dry Hole _____
Abandoned _____

Date

MAY 5 1927

CHAS. L. SHERWOOD

Scout