

Woodson

Form 51-5M-9-28-27423

Map No. KANSAS Sec. 23 Twp. 26 R. 14

Well No. 5 - Lamb Farm
Purless O&K Company

NORTH

				0			

WEST

EAST

SOUTH

Location.....

Drilling Remarks

.....

.....

Rig Up.....

Drilling Remarks

.....

.....

RECORD

Cased..... in..... ft.

Sand.....

Gas.....

Oil.....

Total Depth.....

PRODUCTION

1st 24 hrs. Nat.....

1st 24 hrs. after shot.....

Gas..... cu. ft.....

Dry Hole.....


Abandoned.....

Woodson

Map No. **KANSAS** Sec. *23* Twp. *26* R. *14*

Well No. *5 - Lauber* Farm
Purless O & R. Company

1170 Ft. from N. Line
..... Ft. from S. Line
..... Ft. from E. Line
150 Ft. from W. Line

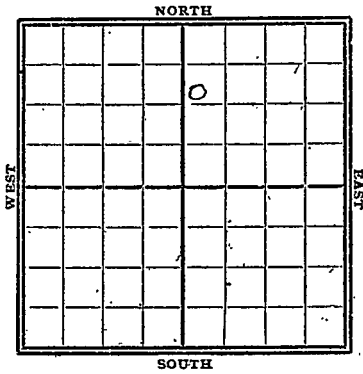

1929

Date

REPORT

1/12 sand 1210-66
TD 1303'
shot 160 gts
IP 200 bbls
21 gravity
Comp.

Woodson

Map No. *Nonmap* **KANSAS** Sec. *73* Twp. *26* R. *14*

Well No. *5 Kauber*
Fearless Oil Co Company

FIRST REPORTS
 COMPLETE Contractor

SECTION PLAT

1170 Ft. from N. Line
 Ft. from S. Line
 Ft. from E. Line
150 Ft. from W. Line

		0	

Location.....

Rig up.....

Drilling and Remarks:

160 / J.P. 200 Bls.

21 gravity

RECORD

Cased..... in. ft.
 Sand *1210-1266*
 Gas.....
 Oil.....
 Total Depth *1303*

PRODUCTION

1st 24 hrs. Nat.....
 1st 24 hrs. after shot.....
 Gas..... Cu. Ft.
 Dry Hole.....
 Abandoned.....

Date

1/12/29

192.....

CHAS. L. SHERWOOD

Scout