


Woodson

Map No. Kansas Sec. 23 Twp. 26 R. 12

Well No. 5 Lauber Farm

Peerless O & P Company

NORTH

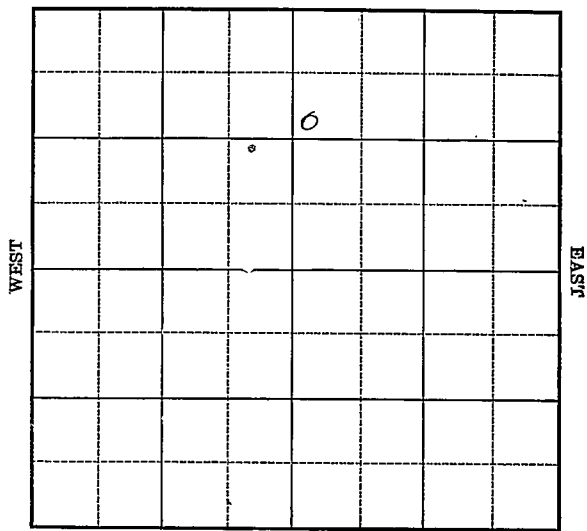

SOUTH

Location _____

Drilling Remarks _____

RECORD

Cased _____ in. _____ ft.

Sand _____

Gas _____

Oil _____

Total Depth _____

Rig Up _____

Drilling Remarks _____

PRODUCTION

1st 24 hrs. Nat. _____

1st 24 hrs. after shot _____

Gas _____ cu. ft.

Dry Hole _____

Abandoned _____

Woodson

Map No. ^{no map} KANSAS Sec. 23 Twp. 26 R. 14

Well No. 5, Leuben
 Leubers Oil Co. Company

Contractor

FIRST REPORTS

SECTION PLAT

1/20 Ft. from N. Line
 _____ Ft. from S. Line
 _____ Ft. from E. Line
 200 Ft. from W. Line

		o	

Location D.
 Rig up machine
 Drilling and Remarks:

RECORD

Cased _____ in., _____ ft.
 Sand _____
 Gas _____
 Oil _____
 Total Depth _____

PRODUCTION

1st 24 hrs. Nat. _____
 1st 24 hrs. after shot _____
 Gas _____ Cu. Ft.
 Dry Hole _____
 Abandoned _____

Date

MAY 12 1926

CHAS. L. SHERWOOD
 Scout

Wood Son

Map No. KANSAS Sec. 23 Twp. 26 R. 14

Well No. 5 Lauber

Peerless Oil

Company

Contractor

COMPLETED

SECTION PLAT

1120 Ft. from N. Line

_____ Ft. from S. Line

_____ Ft. from E. Line

200 Ft. from W. Line

		6	

Location _____

Rig up _____

Drilling and Remarks:

16ay 150 lbs.
21 Snowite

RECORD

Cased _____ in., _____ ft.

Sand 1210-1266

Gas _____

Oil _____

Total Depth 1203

PRODUCTION

1st 24 hrs. Nat. _____

1st 24 hrs. after shot _____

Gas _____ Cu. Ft.

Dry Hole _____

Abandoned _____

Date

JUL 21 1926

CHAS. L. SHERWOOD