

Form 51—5M—9-28—27423

Map No. KANSAS Sec. 23 Twp. 26 R. 14

Well No. 9-14000 Farm 14000

Company

NORTH

[illegible]

SOUTH

Location_____

Drilling Remarks

Rig Up.....

Drilling Remarks

RECORD

Cased.....in.....ft.

Sand_____

Gas_____

Oil.....

Total Depth.....

PRODUCTION

1st 24 hrs. Nat.....

1st 24 hrs. after shot.....

Gas.....cu. ft.....

Dry Hole.....

Abandoned.....

Hoodson

Form 252. —5M—5-28—Mid-West

Map No. KANSAS Sec. 23 Twp. 26 R. 14


Well No. 9 - Lauber Farm
Pearless O & R. Company

..... Ft. from N. Line

990 Ft. from S. Line

..... Ft. from E. Line

1170 Ft. from W. Line

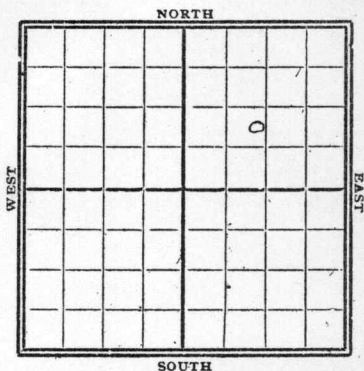

1929

Date

REPORT

1/12 sand 1219-86'

T.D. 1307'

shot 180 qt

I.P. 200 bbls.

21 gravity
Somp.

Map No. *KANSAS* Sec. *23* Twp. *26* R. *14*

Well No. *9* *hander*
Peerless Oil Co Company

FIRST REPORTS

Contractor

COMPLETE

SECTION PLAT

Ft. from N. Line

990 Ft. from S. Line

Ft. from E. Line

1170 Ft. from W. Line

RECORD

Location

Cased *1219-1286* in., ft.

Rig up

Sand

Drilling and Remarks:

Gas

Oil

Total Depth *1307*

PRODUCTION

1st 24 hrs. Nat.

1st 24 hrs. after shot

Gas Cu. Ft.

Dry Hole

Abandoned

Date

1/12/29 192 *CHAS. L. SHERWOOD* Scout