



Woodson

Form 252A-5M-5-28-Mid-West

Map No. **KANSAS** Sec. 23 Twp. 26 R. 14


Well No. 4 Lauch Farm  
Peerless Oil & R. Company

1170 Ft. from N. Line

..... Ft. from S. Line

150 Ft. from E. Line

..... Ft. from W. Line

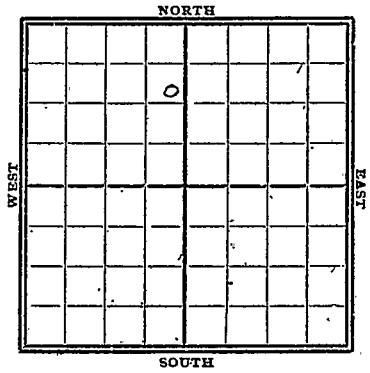

1929

Date

REPORT

1/12

sand 1220-67'

T.D. 1275'

shot 160 gts

I.P. - 285 bbl

21 gravity  
Completed

*Woodson*

Map No. **KANSAS** Sec. *23* Twp. *26* R. *14*

Well No. *4* *Lawrence*  
*Peerless Oil Co* Company

**FIRST REPORTS  
COMPLETE**

Contractor

**SECTION PLAT**

	10		

*1170* Ft. from N. Line

..... Ft. from S. Line

*150* Ft. from E. Line

..... Ft. from W. Line

Location.....

Rig up.....

Drilling and Remarks:

*1100 / 1P 285 lbs*  
*71 gravity.*

**RECORD**

Cased..... in., ..... ft.

Sand *1220-1267*

Gas.....

Oil.....

Total Depth *1275*

**PRODUCTION**

1st 24 hrs. Nat.....

1st 24 hrs. after shot.....

Gas..... Cu. Ft.

Dry Hole.....

Abandoned.....

Date

*11/2/29*

192

**CHAS. L. SHERWOOD**

Scout