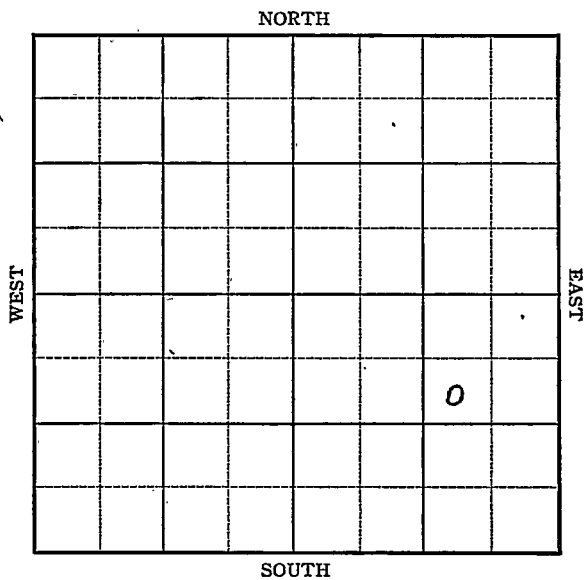


KANSAS

Barton

Section 28 Township 16 Range 11-WWell No. #7 EsfeldCompany Black-Marshall

KANSAS

Barton County

Sec. 28 - Twp. 16 R. 11W

Well No. #7 Esfeld Farm

Black-Marshall Company


Kraft-Prusa

990 Ft. from N. Line

Ft. from S. Line

990 Ft. from E. Line

Ft. from W. Line

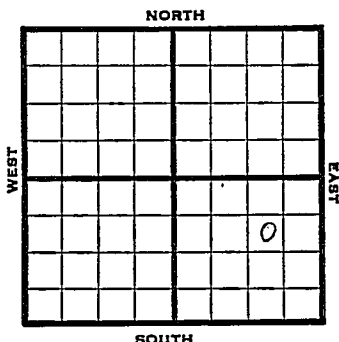

SW NE SE . . .

1946 Elev. 1923' REPORT

1/16 Location

1/24 R U R

1/31 8" - 317' Drlg. 1810'

2/6 Lans. 3065' Arb. 3354-57' T.D.

5" - 3355' RUST.

2/14 " " "

2/20 Arb. 3354

5" @ 3355

TD 3360'

Pump 401 Pot.

Grav. 42.0

COMPLETED

**KANSAS**

Kansas

Pool Name Kraft-PrusaMap No. 55 Sec. 28 Twp. 16 R. 11WWell No. 7 EsfeldBlack-Marshall

Company

**FIRST REPORT**

Contractor

SW NE SE

**SECTION PLAT**

|  |  |  |  |
|--|--|--|--|
|  |  |  |  |
|  |  |  |  |
|  |  |  |  |
|  |  |  |  |

990 Ft. from N. Line       Ft. from S. Line990 Ft. from E. Line       Ft. from W. LineBarton County**RECORD**Location XCased        in.,        ft.Rig up       Sand       

Drilling and Remarks:

Gas       Oil       Total Depth       **PRODUCTION**1st 24 hrs. Nat.       1st 24 hrs. after shot       Gas        Cu. Ft.Dry Hole       Abandoned       

Date

JAN 1 6 194619S. J. LEWISScout

KANSAS Kansas Pool Name Kraft-Prusa  
 Map No. 35 Sec. 28 Twp. 16 R. 11W  
 Well No. 7 Esfeld

Black-Marshall

Company

**COMPLETED**

Contractor

SW NE SE

E11923  
**SECTION PLAT**

990 Ft. from N. Line

\_\_\_\_\_ Ft. from S. Line

990 Ft. from E. Line

\_\_\_\_\_ Ft. from W. Line

|  |  |  |   |
|--|--|--|---|
|  |  |  |   |
|  |  |  |   |
|  |  |  |   |
|  |  |  | 0 |
|  |  |  |   |

**Barton county**

Location \_\_\_\_\_

Rig up \_\_\_\_\_

Drilling and Remarks:

*Cr 3354*  
*5" 03355*  
*Pump 401 BX*

*42 2 94*

# **RECORD**

Cased \_\_\_\_\_ in., \_\_\_\_\_ ft.

Sand \_\_\_\_\_

Gas \_\_\_\_\_

Oil \_\_\_\_\_

Total Depth 2360

# **PRODUCTION**

1st 24 hrs. Nat. \_\_\_\_\_

1st 24 hrs. after shot \_\_\_\_\_

Gas \_\_\_\_\_ Cu. Ft.

Dry Hole \_\_\_\_\_

Abandoned \_\_\_\_\_

Date

FEB 2 0 1946

19

S. J. LEWIS

Scout