


Barton KANSAS

Section 28 Township 16 Range 11W

Well No. 7 Esfeld

Company Stanolind
Kraft-Prusa

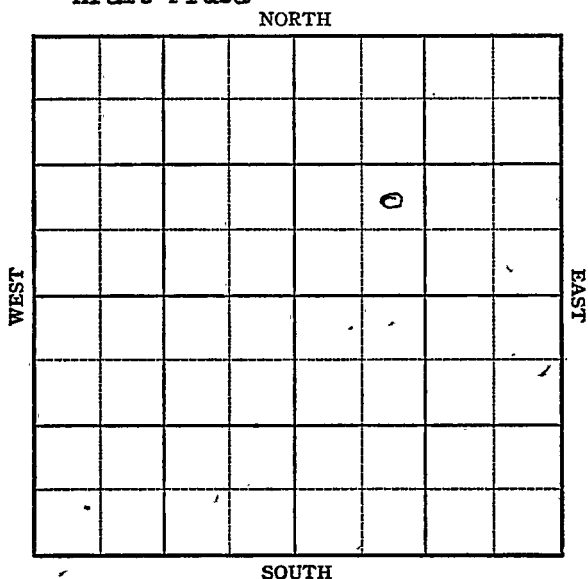


KANSAS

Barton

Sec. 28 Twp. 16 R. 11 ^W Well No. #7 Esfeld Farm
Stanolind Company

 Ft. from N. Line
990 Ft. from S. Line
 Ft. from E. Line
990 Ft. from W. Line

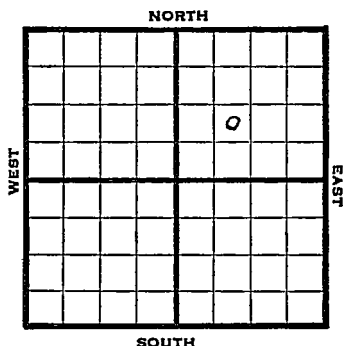

NE SW NE

1947	Elev. 1898'	REPORT
4/9		Rigging up rotary.
4/15		Anhydrite 736' 8" @ 744' Drlg. 2132'
4/23		Lans 3047 Drlg 3271'
4/29		Arb 3330-37 TD 3337' 5" @ 3330 RUST
5/7		1500' oil in 3 hrs
5/13	"	"
5/20	"	"
5/27	"	"
6/3	"	"
6/10	"	"
6/17	"	"
6/25		TD 3337' Arbuckle 3330' 5" @ 3330' Pump 183 Pot Gr. 42.0 Complete
		COMPLETED

KANSAS
Kansas

Kraft-Prusa Pool

Map No. 755 Sec. 28 Twp. 16 R. 11WWell No. 7 EsfeldStanolind CompanyFIRST REPORT Contractor

NE SW NE

SECTION PLAT

		o	

 Ft. from N. Line990 Ft. from S. Line Ft. from E. Line990 Ft. from W. Line

Barton County

Location Rig up

Drilling and Remarks:

R U R

RECORD

Cased in., ft.Sand Gas Oil Total Depth

PRODUCTION

1st 24 hrs. Nat. 1st 24 hrs. after shot Gas Cu. Ft.Dry Hole Abandoned

Date

APR 9 1947 19 S. J. LEWIS Scout

Map No. 55 Sec. 28 Twp. 16 R. 11W

Well No. 7 Esfeld

Stanolind Company

COMPLETE

Contractor

NE SW NE

E1.1898
SECTION PLAT

		6	

 Ft. from N. Line

990 Ft. from S. Line

 Ft. from E. Line

990 Ft. from W. Line

Barton County

Location

Rig up

Drilling and Remarks:

Cr 83330

5' @ 3330

Pump 180 ft

42 1/2 ft

RECORD

Cased in., ft.

Sand

Gas

Oil

Total Depth 2320

PRODUCTION

1st 24 hrs. Nat.

1st 24 hrs. after shot

Gas Cu. Ft.

Dry Hole

Abandoned

Date

JUN 25 1947 19 S. I. LEWIS Scout