

KANSAS


FORM 51. 5M 11-44 PETROL

Barton County

Section 28 Township 16 Range 11W

Well No. #8 Esfeld

Company Black-Marshall

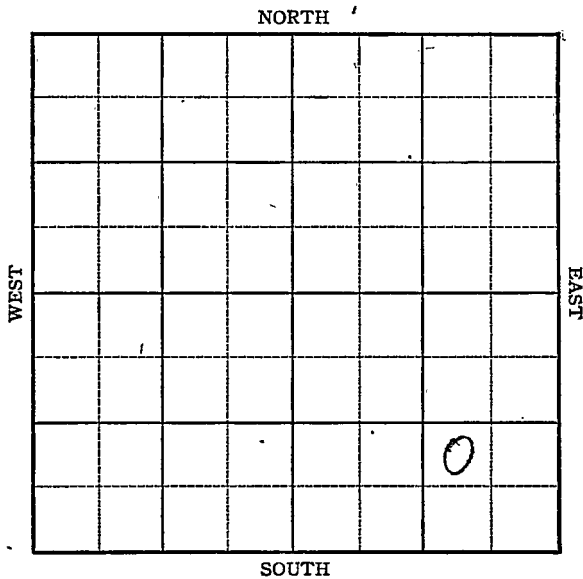

KANSAS

Barton County

Sec. 28 Twp. 16 R. 11W

Well No. #8 Esfeld Farm

Black-Marshall

Company

Kraft-Prusa


 Ft. from N. Line

990 Ft. from S. Line

990 Ft. from E. Line

 Ft. from W. Line

NW SE SE

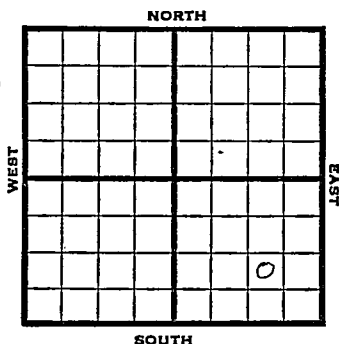

1946

Elev. 1930

R E P O R T

2/13

SH

2/20

Lans 3080

Arb. 3396

TD 3400'

ABANDONED

KANSAS

Kansas Pool Name Kraft-PrusaMap No. 55 Sec. 28 Twp. 16 R. 11WWell No. 8 EsfeldBlack-Marshall

Company

FIRST REPORT

Contractor

NW SE SE

SECTION PLAT

			o

 Ft. from N. Line990 Ft. from S. Line990 Ft. from E. Line Ft. from W. LineBarton CountyLocation Rig up

Drilling and Remarks:

SH

RECORD

Cased in., ft.Sand Gas Oil Total Depth

PRODUCTION

1st 24 hrs. Nat. 1st 24 hrs. after shot Gas Cu. Ft.Dry Hole Abandoned

Date

FEB 13 1946 19S. J. LEWIS Scout

KANSASKansas Pool Name Kraft-PrusaMap No. 55 Sec. 28 Twp. 16 R. 11WWell No. 8 EsfeldBlack-Marshall

Company

ABANDONED

Contractor

NW SE SE

E1, 1930
SECTION PLAT

			o

Ft. from N. Line990 Ft. from S. Line990 Ft. from E. LineFt. from W. LineBarton County

Location _____

Rig up _____

Drilling and Remarks:

Lane 3080Art 2396**RECORD**

Cased _____ in., _____ ft.

Sand _____

Gas _____

Oil _____

Total Depth 3400**PRODUCTION**

1st 24 hrs. Nat. _____

1st 24 hrs. after shot _____

Gas _____ Cu. Ft.

Dry Hole _____

Abandoned _____

Date

FEB 20 1946

19

S. J. LEWIS Scout