


FORM 51 5M PETROL

Section 28 Township 16 Range 11W

Well No. 2 E. Esfeld

Company Stanolind

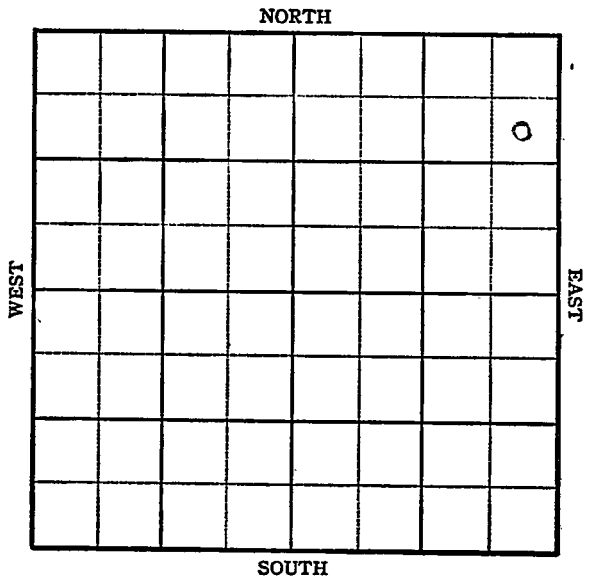

O.W.W.O.


Sec. 28 Twp. 16 R. 11-W

Well No. #2 E. Esfeld Farm

Stanolind

Company

NORTH

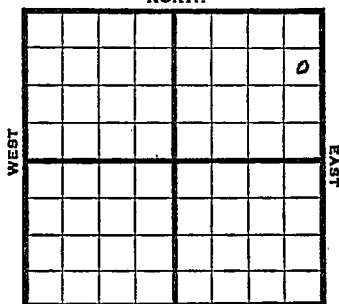

990 Ft. from N. Line

_____ Ft. from S. Line

330 Ft. from E. Line

_____ Ft. from W. Line

SE NE NE

SOUTH

1945

REPORT

Elev. 1919

10/17

Location

10/24

"

10/31

RUR

11/7

8" @ 265

Anhy 740

Drlg. 1330'

11/14

Drlg. 2898

11/21

Lans 3060

DrIg. 3242

11/28

Arb. 3330-3339

TD 3339

5" @ 3333 RUST

12/5

TD 3367

Swb. 5 1/2 oil per hr. 8 hrs.

12/12

Arb. 3360

5" @ 3333

TD 3367

Pump 170 Pot.

Grav. 42.0

COMPLETED

1956

O.W.W.O.

5-23

OTD 3367

5" @ 3333

PB 3290, 20/3236-41

S/4 bwph, 3 hrs., 1000 A

S/ 2 1/2 bwph, 5 hrs., PB 3150 20/3088-

93

(OVER)

1956

5-23 continued

S/ 1 goph, 5 hrs., 1000 A

S/ 3 boph, 7 hrs.,

Comp. 25 bopd

L. 3058', A. 3360'

FIRST REPORT

d
COMPLETED

Kansas Pool Name Kraft-¹ rusa

Map No. 55 Sec. 28 Twp. 16 R. 11W

Well No. 2 E. Hsfeld

Stanolind Company

FIRST REPORT Contractor

SE NE NE

SECTION PLAT

990 Ft. from N. Line

 Ft. from S. Line

330 Ft. from E. Line

 Ft. from W. Line

Barton County

Location X

Rig up

Drilling and Remarks:

RECORD

Cased in., ft.

Sand

Gas

Oil

Total Depth

PRODUCTION

1st 24 hrs. Nat.

1st 24 hrs. after shot

Gas Cu. Ft.

Dry Hole

Abandoned

Date

OCT 17 1945 19

S. J. LEWIS Scout

KANSAS

Kansas Pool Name Kraft-Prusa

Map No. 15-65 Sec. 28 Twp. 16 R. 11W

Well No. 2 E. Esfeld

Stanolind Company

COMPLETED

Contractor

E. J. 1919

SECTION PLAT

SE NE NE

990 Ft. from N. Line

_____ Ft. from S. Line

330 Ft. from E. Line

_____ Ft. from W. Line

Barton County

Location _____

Rig up _____

Drilling and Remarks:

Per X 3360

5" casing

Pump 170 Rod

42 1/2 Gr

RECORD

Cased _____ in., _____ ft.

Sand _____

Gas _____

Oil _____

Total Depth 330 "

PRODUCTION

1st 24 hrs. Nat. _____

1st 24 hrs. after shot _____

Gas _____ Cu. Ft.

Dry Hole _____

Abandoned _____

Date

DEC 12 1945

S. J. LEWIS Scout

O.W.W.O.

County Barton Elev. 1919
 Sec. 28 Twp. 16 Rge. 11W
 Company Stanolind
 Farm Name Esfeld No. 2

TOPS	DEPTH	LOG	DATUM
------	-------	-----	-------

Anb.			
TP.			
H.			
Tr.			
Dg.			
Bl.			
L.	3058		
K.C.			
B.K.C.			
Ce.			
C.			
M.			
M.			
K.			
Mz.			
Mq.			
V.			
S.			
S.			
A.	3360		
R.			
PE.			
G.			
T.D.			

Loc. in Sec. SE NE NE

Geol. _____

Contr. _____

Pool _____

REPORT	
MAY 23 56	
COMPLETE	

Date Comm.

OTD 3367 5" @ 3333 Pb 3290

20/ 3236-41 S/ 1 bwpb 3 hr. 1000 A

S/ 2 1/2 bwpb 5 hr. FB 3150 20/ 3088-93

S/ 1 goph 5 hr. 1000 A S/ 3 boph

7 hr. Comp. 25 bopd

OTD 3367

[Handwritten signature]