

GEOLOGICAL DEPARTMENT
UNION GAS CORPORATION
INDEPENDENCE, KANSAS

Company Thos. M. Galey

S. T. R.
County
State
Lease and
Well No.

28-28-16
Wilson
Kansas
Geo. W. Hall #4

Contractor Joe Van Camp


Drilling May 20, 1924 Drilling
Commenced Completed May 28, 1924

Initial
Production

Initial Rock
Pressure

Location Center of 40 acres (SE $\frac{1}{4}$)

Casing 2" 754'

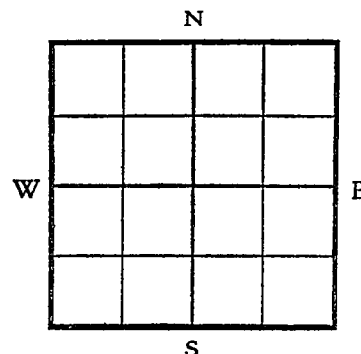

Driller's Record of Formations

shale	700
lime	735
black slate gas water	741
lime	745
black slate gas water	755
shale	980

This well was originally completed in April 1923. Total depth 1275'. When passing thru the shale gas they noted it in the record but they were carrying too much water. In Oct. 1923 the well began to heave out the water. Hall tubed it to 185' and it began producing 60,000 cu. ft. per day.