
Barton KANSAS

Form 51—5M—11-38—Palace

Section 28 Township 16 Range 11-W

Well No. 3 Seyfert

Company Sinclair Prairie

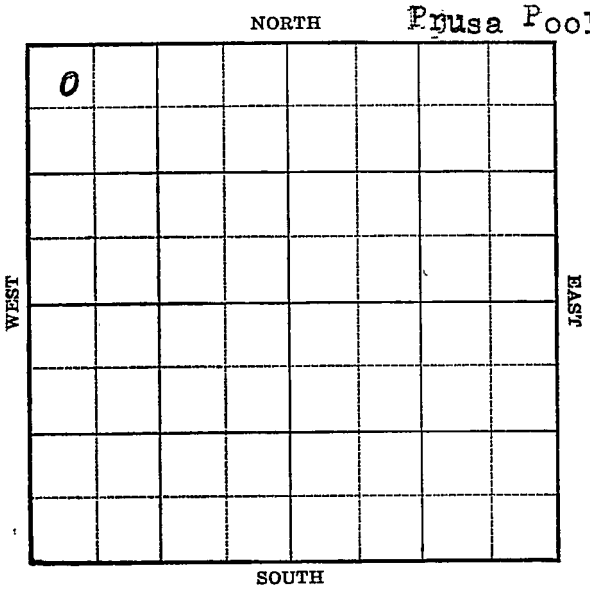

FORM 252-A 5M 1.0-38 KANSAS Barton

Sec. 28 Twp. 16 R. 11-W

Well No. #3 Seyfert Farm

Sinclair-Prairie Company


(Prusa)

440 Ft. from N. Line

Ft. from S. Line

Ft. from E. Line

440 Ft. from W. Line

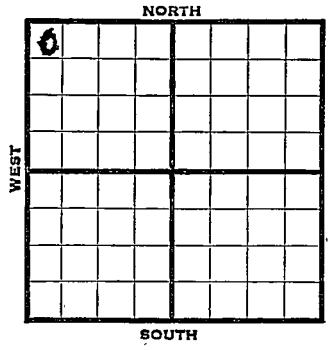

Elev. 1924

1939	REPORT
4/26	Location
5/5	Rig.
5/12	10" - 120' Drlg. 1735'
5/19	Drlg. 3340'
5/26	Arb. 3348' 7" - 3348'
	T.D. 3364' 1800' oil 15 hrs.
	Run tubing.
5/31	Arb. 3348'
	7" - 3348'
	2000 acid.
	T.D. 3364'
	Pump 143 bbls.
	COMPLETED

Form 26—1M Bks.—2-29 Barton KANSAS

Map No. 55 Sec. 28 Twp. 16 R. 11W

Well No. 3 Seyfert

Sinclair Prairie Company

Contractor

FIRST REPORT

NW/C

440 Ft. from N. Line


_____ Ft. from S. Line

_____ Ft. from E. Line

440 Ft. from W. Line

PRUSA POOL

SECTION PLAT

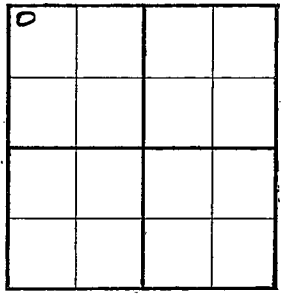

Location X

Rig up

Drilling and Remarks:

RECORD

Cased _____ in., _____ ft.

Sand

Gas

Oil

Total Depth

PRODUCTION

1st 24 hrs. Nat.

1st 24 hrs. after shot

Gas _____ Cu. Ft.

Dry Hole

Abandoned

Date

APR 26 1939 19

H. D. Hatfield Scout

Form 26—1M Bks.—2-29 Barton KANSAS

Map No. 53 Sec. 28 Twp. 16 R. 11W

Well No. 3 Seyfert

Sinclair Prairie etal Company

Contractor

COMPLETED

NW/C

440 Ft. from N. Line


_____ Ft. from S. Line

_____ Ft. from E. Line

440 Ft. from W. Line

PRUSA POOL

SECTION PLAT

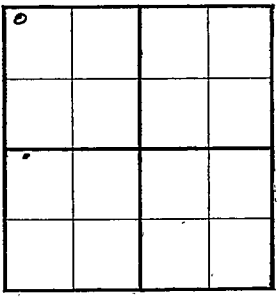

Location _____

Rig up _____

Drilling and Remarks:

Cir & 3348

7" @ 3348.

2000 acid

Pump 143.

RECORD

Cased _____ in., _____ ft.

Sand _____

Gas _____

Oil _____

Total Depth 3364

PRODUCTION

1st 24 hrs. Nat. _____

1st 24 hrs. after shot _____

Gas _____ Cu. Ft.

Dry Hole _____

Abandoned _____

Date

MAY 31 1939 19 S. J. LEWIS Scout