KANSAS


Form 51—5M—7-39—Palace

Barton

Section 28 Township 16 Range 11-W

Well No. #4 Seyfert

Company Sinclair Prairie et al

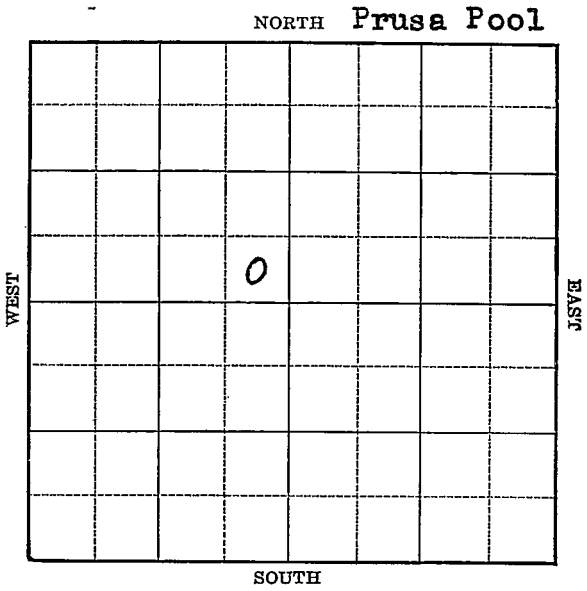

FORM 252-A 5M 4-39 KANSAS Barton

Sec. 28 Twp. 16 R. 11-W

Well No. #4 Seyfert Farm

Sinclair-Prairie et al Company


(Prusa)

_____ Ft. from N. Line

330 Ft. from S. Line

330 Ft. from E. Line

_____ Ft. from W. Line

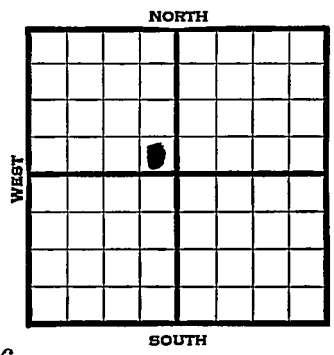

Elev. 1926

1939	REPORT
8/30	Rotary.
9/7	10" - 96' Drlg. 2020'
9/14	Lans. 3052' Coring 3350'
9/20	Arb. 3377'
	T.D. 3384' Water.
	ABANDONED

Form 26—1M Bks.—2-24 KANSAS Barton

Map No. 55 Sec. 28 Twp. 16 R. 11W

Well No. 4 Sayler


Sinclair Prairie & Va. Company

Contractor

SE NW

FIRST REPORT

SECTION PLAT

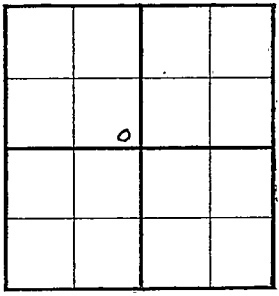

____ Ft. from N. Line

330 Ft. from S. Line

330 Ft. from E. Line

____ Ft. from W. Line

Pusa Pool

Location ____

Rig up ____

Drilling and Remarks:

Rotary

RECORD

Cased ____ in., ____ ft.

Sand ____

Gas ____

Oil ____

Total Depth ____

PRODUCTION

1st 24 hrs. Nat. ____

1st 24 hrs. after shot ____

Gas ____ Cu. Ft.

Dry Hole ____

Abandoned ____

Date

AUG 30 1939

S. J. LEWIS Scout

Form 26—1M Bks.—2-29 Barton KANSAS

Map No. Sec. 28 Twp. 16 R. 11W

Well No. 4 Seyfert

Sinclair Prairie etal Company

Contractor

ABANDONED

SE NW

Ft. from N. Line


330 Ft. from S. Line

330 Ft. from E. Line

Ft. from W. Line

PRUSA POOL

SECTION PLAT

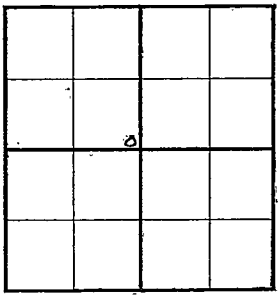

Location

Rig up

Drilling and Remarks:

Ar # 3377

Water.

RECORD

Cased in., ft.

Sand

Gas

Oil

Total Depth 3384

PRODUCTION

1st 24 hrs. Nat.

1st 24 hrs. after shot

Gas Cu. Ft.

Dry Hole

Abandoned

Date

SEP 20 1939 19 S. J. LEWIS Scout