




Woodson

Map No. Kansas Sec. 23 Twp. 26 R. 14

Well No. 1 Town Farm

R. L. Brunegar Company

NORTH

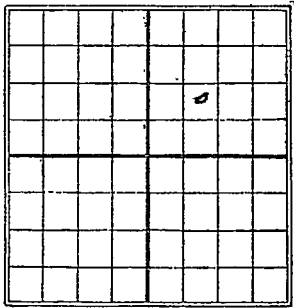

\_\_\_\_\_ Ft. from N. Line

990 Ft. from S. Line

\_\_\_\_\_ Ft. from E. Line

990 Ft. from W. Line

SOUTH

Date	REPORT
<u>1/26</u>	
<u>1/20</u>	<u>Sly 850</u>
<u>1/27</u>	_____
<u>2/4</u>	_____
<u>2/10</u>	<u>J.S. 1195' J.D. 1267' Est 30</u> <u>bbble nat. shot 100 gts, 200 bbls</u> <u>exploded Est 200 bbls. yesterday</u> <u>1st 2 days, using tubing &amp; rods</u> <u>oil tests 23.5 gravity</u>
<u>2/17</u>	_____
<u>2/24</u>	<u>Sand 1195-1267 100 gts</u> <u>75 Bbls 23.5 Gravity</u>
-	-

Hudson Co

Map No. <sup>nomap</sup> KANSAS Sec. 22 Twp. 26 R. 14

Well No. 1 Town \_\_\_\_\_  
R. H. Blingard \_\_\_\_\_ Company  
\_\_\_\_\_ Contractor

FIRST REPORTS

SECTION PLAT

\_\_\_\_\_ Ft. from N. Line  
990 Ft. from S. Line  
\_\_\_\_\_ Ft. from E. Line  
990 Ft. from W. Line

		o	

Location \_\_\_\_\_  
Rig up \_\_\_\_\_  
Drilling and Remarks:

Delay 850'

RECORD

Cased \_\_\_\_\_ in., \_\_\_\_\_ ft.  
Sand \_\_\_\_\_  
Gas \_\_\_\_\_  
Oil \_\_\_\_\_  
Total Depth \_\_\_\_\_

PRODUCTION

1st 24 hrs. Nat. \_\_\_\_\_  
1st 24 hrs. after shot \_\_\_\_\_  
Gas \_\_\_\_\_ Cu. Ft.  
Dry Hole \_\_\_\_\_  
Abandoned \_\_\_\_\_

Date

JAN 20 1926

CHAS. L. SHERWOOD  
Scout

*Woodrow Co*

Map No. *10 maps* **KANSAS** Sec. *23* Twp. *26* R. *14*

Well No. *1 down*  
*G. L. Blingon* Company

Contractor

**COMPLETED**

**SECTION PLAT**

\_\_\_\_\_ Ft. from N. Line

*990* Ft. from S. Line

\_\_\_\_\_ Ft. from E. Line

*990* Ft. from W. Line

		o	

Location \_\_\_\_\_

Rig up \_\_\_\_\_

Drilling and Remarks:

*1004 75 88  
 23.5 Gravity*

**RECORD**

Cased \_\_\_\_\_ in., \_\_\_\_\_ ft.  
 Sand *1195-1267*  
 Gas \_\_\_\_\_  
 Oil \_\_\_\_\_  
 Total Depth *1267*

**PRODUCTION**

1st 24 hrs. Nat. \_\_\_\_\_  
 1st 24 hrs. after shot \_\_\_\_\_  
 Gas \_\_\_\_\_ Cu. Ft.  
 Dry Hole \_\_\_\_\_  
 Abandoned \_\_\_\_\_

Date

**FEB 24 1926**

**CHAS. L. SHERWOOD**

192

Scout