


Section 27 Township 17 Range 10-W

Well No. #1 Schepmann

Company Central Petroleum

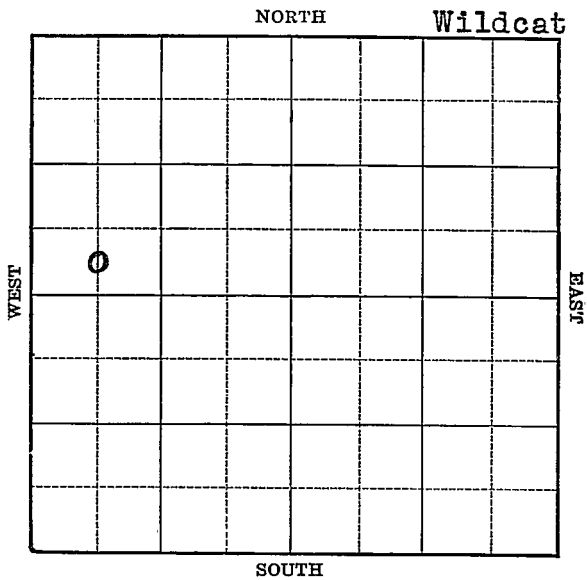

KANSAS

Ellsworth

Sec. 27 Twp. 17 R. 10-W

Well No. #1 Schepmann Farm

Central Petr. Company

(Wildcat)


\_\_\_\_\_ Ft. from N. Line

330 Ft. from S. Line

\_\_\_\_\_ Ft. from E. Line

660 Ft. from W. Line

Elev. 1839

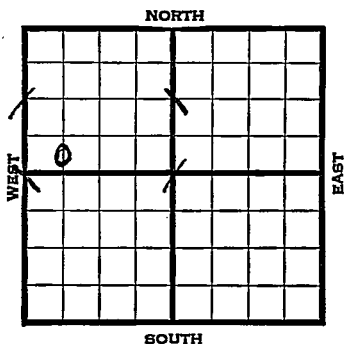

| 1939 | REPORT                        |
|------|-------------------------------|
| 8/9  | Rotary.                       |
| 8/17 | 13" - 225' Anhy 583'          |
|      | Drlg. 1568'                   |
| 8/24 | Drlg. 2896'                   |
| 8/31 | Lans. 2987' Cong. 3295'       |
|      | Arb. 3321' S.O. 3321-25' T.D. |
|      | 5" - 3323' RUST.              |
| 9/7  | " " "                         |
|      |                               |
| 9/13 | Arb. 3321'                    |
|      | 5" - 3323'                    |
|      | T.D. 3339'                    |
|      | Water.                        |
|      | <b>ABANDONED</b>              |
|      |                               |
|      |                               |
Map No. \_\_\_\_\_ Sec. 27 Twp. 17 R. LOW

Well No. 1 Schepmann

Central Petroleum Company

Contractor

**FIRST REPORT**

**C S L SW NW**

\_\_\_\_\_ Ft. from N. Line

330 Ft. from S. Line

\_\_\_\_\_ Ft. from E. Line

660 Ft. from W. Line

**WILDCAT**

**SECTION PLAT**

|   |  |   |  |
|---|--|---|--|
|   |  |   |  |
| X |  | X |  |
| o |  | X |  |
|   |  |   |  |

Location \_\_\_\_\_

Rig up \_\_\_\_\_

Drilling and Remarks:

**ROTARY**

**RECORD**

Cased \_\_\_\_\_ in., \_\_\_\_\_ ft.

Sand \_\_\_\_\_

Gas \_\_\_\_\_

Oil \_\_\_\_\_

Total Depth \_\_\_\_\_

**PRODUCTION**

1st 24 hrs. Nat. \_\_\_\_\_

1st 24 hrs. after shot \_\_\_\_\_

Gas \_\_\_\_\_ Cu. Ft.

Dry Hole \_\_\_\_\_

Abandoned \_\_\_\_\_

Date

AUG 9 1938

19

S. J. LEWIS Scout

Map No. \_\_\_\_\_ Sec. 27 Twp. 17 R. 10W

Well No. 1 Schepmann

Central Petroleum etal Company

Contractor

**ABANDONED**

C S L SW NW

\_\_\_\_\_ Ft. from N. Line'

330 Ft. from S. Line

\_\_\_\_\_ Ft. from E. Line

660 Ft. from W. Line

**WILDCAT**

**SECTION PLAT**

|  |  |  |  |
|--|--|--|--|
|  |  |  |  |
|  |  |  |  |
|  |  |  |  |
|  |  |  |  |

Location \_\_\_\_\_

Rig up \_\_\_\_\_

Drilling and Remarks:

*Cor & 3321*

*5' @ 3323*

*Water*

**RECORD**

Cased \_\_\_\_\_ in., \_\_\_\_\_ ft.

Sand \_\_\_\_\_

Gas \_\_\_\_\_

Oil \_\_\_\_\_

Total Depth 3329

**PRODUCTION**

1st 24 hrs. Nat. \_\_\_\_\_

1st 24 hrs. after shot \_\_\_\_\_

Gas \_\_\_\_\_ Cu. Ft.

Dry Hole \_\_\_\_\_

Abandoned \_\_\_\_\_

Date

SEP 13 1939 19

S. J. LEWIS

Scout