


Section 28 Township 17 Range 10-W

Well No. #1 Peterman

Company J J Lynn
Stoltenberg Pool

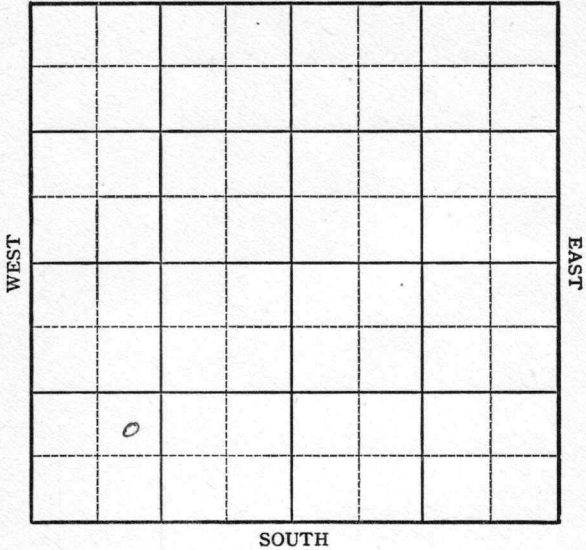

Sec. 28 Twp. 17 R. 10W

Well No. #1 Peterman Farm

J. J. Lynn Company


Stoltenberg (Sterling Drlg., Contr.)
Pool

_____ Ft. from N. Line

990' Ft. from S. Line

_____ Ft. from E. Line

990' Ft. from W. Line

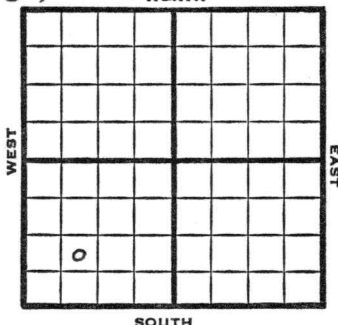

NE SW SW

1949 Elev 1809' REPORT

11/16	Location
11/23	8" @ 226'
	Drlg 1929'
11/29	Lan sing 2966'
	Arb. 3263-79'
	TD 3279'
	5" @ 3264'
12/7	500 acid
	1/2 bbls oil / W PH
	32 Cones shots 3264-71
	No help
	Drlg 3294'
12/14	TD 3297'
	1000 acid swb 4 bbls oil PH
12/21	TD 3297'
	Arb. 3263'
	5 @ 3264'
	150 acid
	Pump 167 Oil / 6% W Pot
	42° Gr.
	Comp

COMPLETED

Kansas

Map No. _____ Sec. 28 Twp. 17 R. 10W

Well No. 1 Peterman

J. J. Lynn Company

Sterling Drlg. Contractor

NE SW SW

FIRST REPORT
SECTION PLAT

_____ Ft. from N. Line

990 Ft. from S. Line

_____ Ft. from E. Line

990 Ft. from W. Line

Ellsworth County

Location X

Rig up _____

Drilling and Remarks:

RECORD

Cased _____ in., _____ ft.

Sand _____

Gas _____

Oil _____

Total Depth _____

PRODUCTION

1st 24 hrs. Nat. _____

1st 24 hrs. after shot _____

Gas _____ Cu. Ft.

Dry Hole _____

Abandoned _____

Date

NOV 16 1949

19

S. J. LEWIS

Scout

Kansas

Map No. _____ Sec. 28 Twp. 17 R. 10W

Well No. 1 Peterman

J. J. Lynn Company

COMPLETE

Contractor

NE SW SW

E 1/809
SECTION PLAT

Ft. from N. Line

990 Ft. from S. Line

Ft. from E. Line

990 Ft. from W. Line

Ellsworth County

RECORD

Location _____

Cased _____ in., _____ ft.

Rig up _____

Sand _____

Drilling and Remarks:

Gas _____

Oil _____

Total Depth 3297

PRODUCTION

1st 24 hrs. Nat. _____

1st 24 hrs. after shot _____

Gas _____ Cu. Ft.

Dry Hole _____

Abandoned _____

Date

DEC 21 1949 19

S. J. LEWIS

Scout

Art 3263
5" @ 3264
1500 acid
Pump 167 oil + 6 9/16
BT
42 2/3