


Section 28 Township 17 Range 10W

Well No. #2 Peterman

Company J. J. Lynn

Bloomer Pool

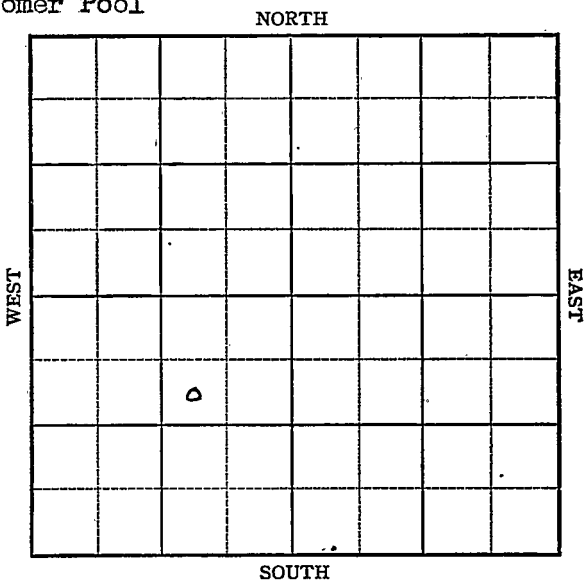

Ellsworth  
17

KANSAS  
107

Sec. 28 Twp. \_\_\_\_\_ R. \_\_\_\_\_

Well No. #2 Peterman Farm \_\_\_\_\_

J. J. Lynn

Company \_\_\_\_\_


Bloomer Pool (Sterling Drlg., Contr.)

990' Ft. from N. Line

\_\_\_\_\_ Ft. from S. Line

990' Ft. from E. Line

\_\_\_\_\_ Ft. from W. Line

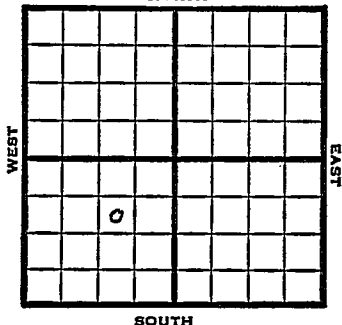

SW NE SW

1949

Elev 1805'

REPORT

12/14

8" @ 262'

12/21

Drlg 2887'

12/28

Lansing 2966'

Arb. 3280-90'

TD 3290'

5" @ 3286'

1950

1/18

TD 3290'

8" @ 262'

5" @ 3286'

PP 103 BOPD

15% wtr.

Anhy 560'

Lans 2966'

Cong 3255'

Arb. 3280'

Comp

**COMPLETED**

Kansas

Map No. \_\_\_\_\_ Sec. 28 Twp. 17 R. 10W

Well No. 2 Peterman

J. J. Lynn \_\_\_\_\_ Company

Sterling Drlg. \_\_\_\_\_ Contractor

SW NE SW

FIRST REPORT  
SECTION PLAT

990 \_\_\_\_\_ Ft. from N. Line


\_\_\_\_\_ Ft. from S. Line

990 \_\_\_\_\_ Ft. from E. Line

\_\_\_\_\_ Ft. from W. Line

Ellsworth County

Location \_\_\_\_\_

Rig up \_\_\_\_\_

Drilling and Remarks:

8" @ 262

## RECORD

Cased \_\_\_\_\_ in., \_\_\_\_\_ ft.

Sand \_\_\_\_\_

Gas \_\_\_\_\_

Oil \_\_\_\_\_

Total Depth \_\_\_\_\_

## PRODUCTION

1st 24 hrs. Nat. \_\_\_\_\_

1st 24 hrs. after shot \_\_\_\_\_

Gas \_\_\_\_\_ Cu. Ft.

Dry Hole \_\_\_\_\_

Abandoned \_\_\_\_\_

Date

DEC 14 1949 19 \_\_\_\_\_ S. J. LEWIS Scout

Map No. \_\_\_\_\_ Sec. 28 Twp. 17 R. 10WWell No. 2 Peterman\_\_\_\_\_  
J. J. Lynn Company

Contractor

SW NE SW

66 1805  
SECTION PLAT990 Ft. from N. Line

\_\_\_\_\_ Ft. from S. Line

990 Ft. from E. Line

\_\_\_\_\_ Ft. from W. Line

COMPLETE			
	0		

Ellsworth County

Location \_\_\_\_\_

Rig up \_\_\_\_\_

Drilling and Remarks:

8" @ 2625" @ 3286PP-103 BOPD15% water

## RECORD

Cased \_\_\_\_\_ in., \_\_\_\_\_ ft.

Sand \_\_\_\_\_

Gas \_\_\_\_\_

Oil \_\_\_\_\_

Total Depth 3290

PRODUCTION

1st 24 hrs. Nat. 855 gal.1st 24 hrs. after shot 1500 gal.

Gas \_\_\_\_\_ Cu. Ft.

Dry Hole \_\_\_\_\_

Abandoned \_\_\_\_\_

Date

JAN 18 1950

19

J. E. TYRA Scout

anh 560  
Lens 2966  
Cong 3255  
chk. 3280

Scout Cards

Land Small Map

Land Wall Map

Tracings

France Map

Pierce Map

Misc.

JAN 20 1950