

KANSAS


FORM 51 25M 3-49 PETROL

Ellsworth

Section 29 Township 17 Range 10-W

Well No. #10 Jansen

Company Okmar Oil

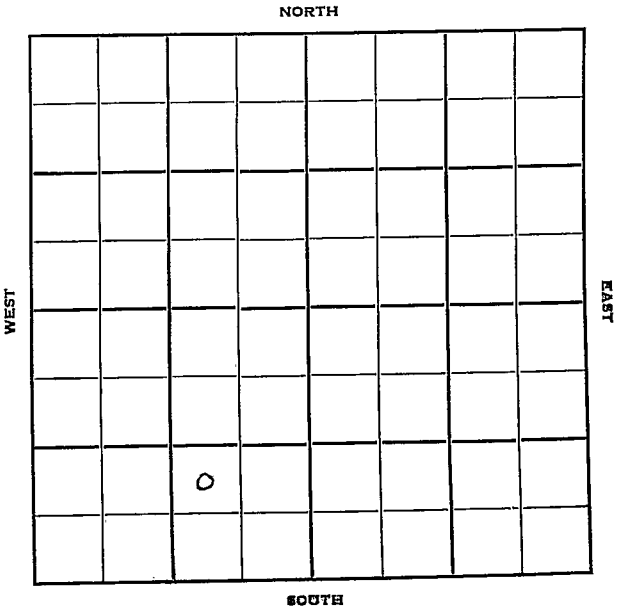

Sec. 29 Twp. 17 R. 10W

Well No. #10 Jansen Farm

Okmar Oil Company

Bloomer Pool Contractor


_____ Ft. from N. Line

990' Ft. from S. Line

990' Ft. from E. Line

_____ Ft. from W. Line

NW SE SW

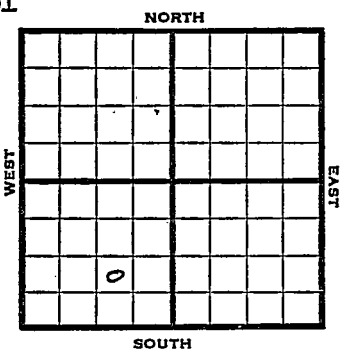

1950

Elev. 1788' REPORT

9/20

Spud 9-11-50
 8" @ 250'
 Lans. 2961'
 Cong. 3244'
 Arb. 3256'
 TD 3260'
 5" @ 3258'
 WOC

10/4

Spud 9-11-50
 OilWell TD 3280'
 8" @ 250'
 Lans. 2961' Cong. 3244'
 Arb. 3256'
 TD 3260'
 5" @ 3258'
 TD 3280'
 Comp. 24 BOPD

COMPLETED

County Ellsworth State Kansas

Sec. 29 (Blk.) 17 (Sur.) 10W Map No.

Operator Okmar Oil

Well No. 10 Farm Jansen

Elev. 1788 Location NW SE SW

990 Ft. From S Line SW

990 Ft. From E Line Quarter

Ist. Report SEP 20 1950

Completion _____

Remarks _____

Spudding Date 9-11-50

Drlg. Data Bloomer Pool

8" @ 250 Lens, 2961 Cong. 3244

Arb. 3256 TD 3260 5" @ 3258 WOC

J. E. TYRA

