

Sec. 29 Twp. 17 R. 10-W

Well No. #1 Janssen Farm

Gulf Company

(Semi-Wildcat)


_____ Ft. from N. Line

330 Ft. from S. Line

_____ Ft. from E. Line

330 Ft. from W. Line

Elev. 1795

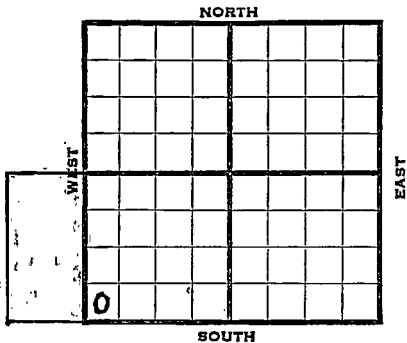

1939	REPORT
4/19	Rotary tools on ground.
4/25	Dlg. 2125 (Tel)
4/26	Dlg. 2415 (Tel)
4/28	10" - 210' Drlg. 2415'
5/1	Top Lansing 2960 Slight stain Dlg. 3142 Going to Arbuckle (Tel)
5/4	Top Arbuckle 3254 T.D. 3257 Slight stain Not much porosity -- Formation hard Will run pipe (Tel)
Running	24' higher on Arbuckle than Continental
	#1 Janssen dry hole SE/c 29-17-10W
Running	2' higher on Arbuckle than
	Transwestern #2 Disque a 1814 bbl. well NE SE 32-17-10W
Running	42' higher on Arbuckle than Magnolia
	#1 Ehly dry hole NW SE 30-17-10W
5/8	Drilled 6 feet deeper T.D. 3263 Cleaned out and let set 1 hour Filled 150 feet oil in 1 hour No Water May acidize
	OVER OVER

- 5/9--Top Arbuckle 3254 At T.D. 3263 cleaned out and let set 1 hour Filled 150 feet oil No water
 Cored 3263-65 Recovered 1' hard lime no porosity Cored 3265-67
 Recovered 1½' hard lime No porosity
 T.D. 3267 Bailed 1 hour with small bailer and bailed at the rate of 5 bbls. per hour At end of hour still had 250' oil in hole Bailed 1 more hour and bailed at the rate of 5 bbls. per hour At the end of the hour still had 400 feet oil in hole Swabbed estimated 50 bbls. oil next 7 hrs No water Shut down for orders
 May acidize (If well takes acid estimate around 1000 bbl. well) (Tel)
- 5/10--Cored 3267-72 Recovered brown lime (No record of recovery)
 Had 800 feet oil in hole Filled up from 800 feet oil to 1600 feet in 1½ hours after coring Will take swabbing test
- 5/11--Swab 20 bbls. per hour for 8 hours Running tubing Will acidize (Tel)
- 5/12--Acidized with 2000 gallons.
 Will take potential Saturday or Sunday
- 5/15--Took pumping potential Potential 716 bbls.
 Cutting 1.2% water (Tel)
- 5/17 Arb. 3254'
 7" - 3254'
 T.D. 3272'
 2000 acid.
 Pump potential 716 bbls.
 1.2 % water.
 42. Gravity.

COMPLETED

Ellsworth

Map No. 55 Sec. 29 Twp. 17 R. 10W

Well No. 1 Janssen

Gulf Company

Contractor

FIRST REPORT

SECTION PLAT

SW/C

 Ft. from N. Line

330 Ft. from S. Line

 Ft. from E. Line

330 Ft. from W. Line

SW/C	offset			
	Special			
MC				

SEMI-WILDCAT

RECORD

Location

Cased in., ft.

Rig up

Sand

Drilling and Remarks:

Gas

Rotary Tools on

Oil

Ground

Total Depth

PRODUCTION

1st 24 hrs. Nat.

1st 24 hrs. after shot

Gas Cu. Ft.

Dry Hole

Abandoned

Date

APR 19 1939 19

H. D. Hatfield Scout

Map No. 55 Sec. 29 Twp. 17 R. 10W

Well No. 1 Janssen

Gulf Company

Contractor

COMPLETE
SW/C


_____ Ft. from N. Line

330 Ft. from S. Line

_____ Ft. from E. Line

330 Ft. from W. Line

SECTION PLAT

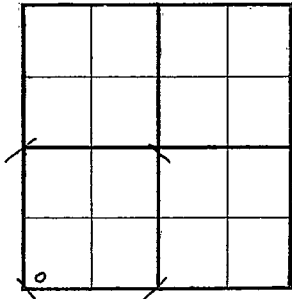

SEMI-WILDCAT

Location _____

Rig up _____

Drilling and Remarks:

Core 3254
7" @ 3254
2000 acid
Pump. P. 716
1.2% Water
42° gravity

RECORD

Cased _____ in., _____ ft.

Sand _____

Gas _____

Oil _____

Total Depth 3272

PRODUCTION

1st 24 hrs. Nat. _____

1st 24 hrs. after shot _____

Gas _____ Cu. Ft.

Dry Hole _____

Abandoned _____

Date

MAY 17 1939₁₉

S. J. LEWIS Scout