

32-28-16E

WELL LOG BUREAU — KANSAS GEOLOGICAL SOCIETY
412 UNION NATIONAL BANK BUILDING - WICHITA, KANSAS

COMPANY

Parrish et al

SEC.

T.

R.

FARM

W.A. Hughes

NO.

2

LOC.

32
ONE-NW

28

16E

TOTAL DEPTH 761

COMM.

COMP. 10-17-24


SHOT OR TREATED

CONTRACTOR

ISSUED

COUNTY

Wilson

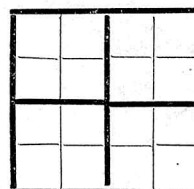

CASING

20	10
15½	8¼
12½	6¾
13¾	5½

ELEVATION

PRODUCTION

FIGURES INDICATE BOTTOM OF FORMATIONS

clay	6	
lime	20	
blue mud	90	
lime	110	
shale blue	117	
lime	125	
shale blue	132	
lime sdy	138	
sand	220	
shale brn	255	
lime	325	
shale sdy	364	
lime	460	
shale drk	510	Gas show
lime	514	
lime shelly	525	
shale light	550	
lime	580	
shale light	657	
lime	685	
shale light	723	
lime	745	First gas
shale blk	749	
shale wht	750	
lime	756	
shale blk	760	70 M gas
shale dark	761	No gas

GEOLOGICAL DEPARTMENT
SOUTHWESTERN GAS COMPANY
INDEPENDENCE, KANSAS

Company

Contractor

Drilling
Commenced

Drilling
Completed

Initial
Production


Initial Rock
Pressure

Location

Casing

S. T. R.
County
State
Lease and
Well No.

33-33-13
Wilson
Kansas
Traces #2

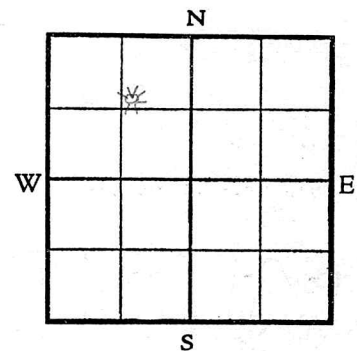

Driller's Record of Formations

clay	0
lime	20
mud	90
lime	110
shale	117
lime	125
shale	140
lime sandy	145
sand water	220
shale broken	325
shale sandy	364
lime	400
shale dark gas	
showing	510
lime	514
lime shelly	525
shale	550
lime	580
shale	657
lime	685
shale	723
lime gas 30,000	745
shale black	749
shale	750
lime	756
shale B. 70,000'	
gas	760
shale dark	761