

KANSAS


FORM 51 IOM 12-46 PETROL

Ellsworth county

Section 29 Township 17 Range 10-W

Well No. #2, Jaissen

Company Derby Oil Company

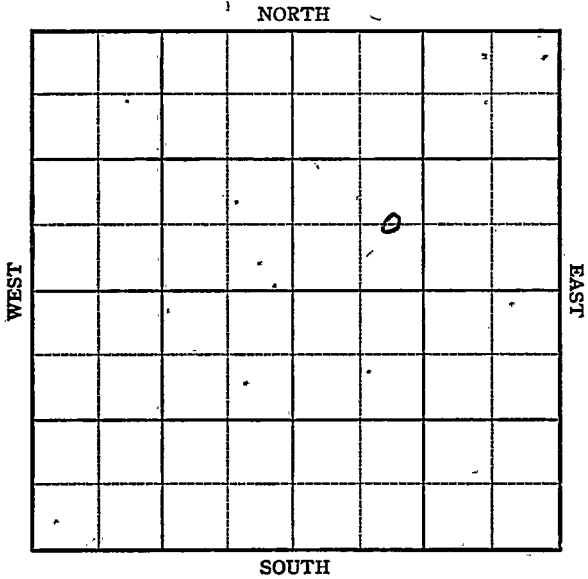

KANSAS

Ellsowrth ✓

Sec. 29 Twp. 17 R. 10-W

Well No. #2, Janssen Farm


Derby Oil Company Company  
Stoltanberg

Ft. from N. Line

660' Ft. from S. Line

Ft. from E. Line

990' Ft. from W. Line

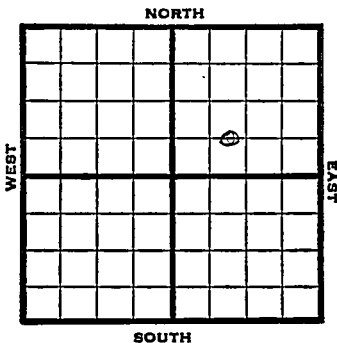

C EL SW NE

1947 ELEV. 1818' REPORT

1/22 Location

2/12 Cong 3265  
3310 in Cong  
TD 3310'

ABANDONED

Kansas KANSAS

Map No. 15 Sec. 29 Twp. 17 R. 10W

Well No. 2 Janssen

Derby Oil Company

**FIRST REPORT**

Contractor

C E L SW NE

**SECTION PLAT**

		o	

         Ft. from N. Line

660 Ft. from S. Line

         Ft. from E. Line

990 Ft. from W. Line

Ellsworth County

Location X

Rig up         

Drilling and Remarks:

**RECORD**

Cased          in.,          ft.

Sand         

Gas         

Oil         

Total Depth         

**PRODUCTION**

1st 24 hrs. Nat.         

1st 24 hrs. after shot         

Gas          Cu. Ft.

Dry Hole         

Abandoned         

Date

JAN 22 1947 19

S. J. LEWIS Scout

Map No. 55 Sec. 29 Twp. 17 R. 10WWell No. 2 Janssen

Derby Oil

Company

ABANDONED

Contractor

C E L SW NE

*E. 1878*  
SECTION PLAT         Ft. from N. Line660 Ft. from S. Line         Ft. from E. Line990 Ft. from W. Line


Ellsworth County

Location         Rig up         

Drilling and Remarks:

*Cong 3265*  
*3310 in Cong.*

## RECORD

Cased          in,          ft.Sand         Gas         Oil         Total Depth 3210

## PRODUCTION

1st 24 hrs. Nat.         1st 24 hrs. after shot         Gas          Cu. Ft.Dry Hole         Abandoned         

Date

FEB 12 1947

19

S. J. LEWIS Scout