


KANSAS Ellsworth county

Section 29 Township 17 Range 10W

Well No. #4, Janssen

Company H.V. Elwell

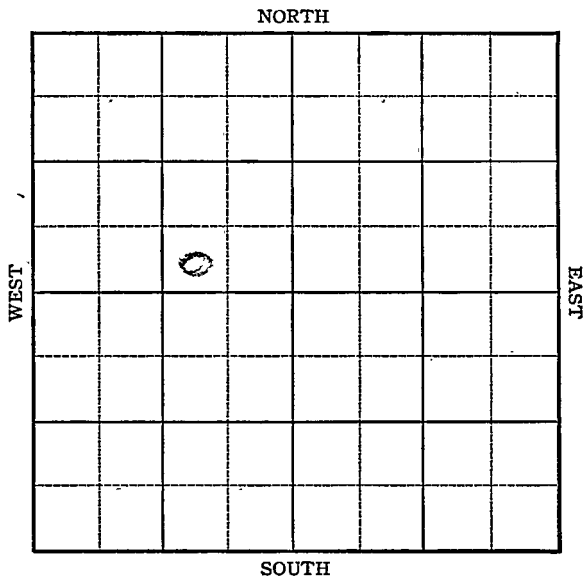

Sec. 29 Twp. 17 R. 10W

Well No. #4 Janssen Farm

H. V. Elwell Company

Stoltenberg


_____ Ft. from N. Line

330 Ft. from S. Line

990 Ft. from E. Line

_____ Ft. from W. Line

SW SE NW

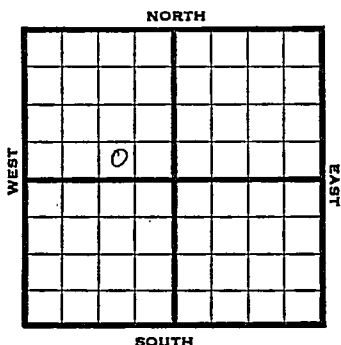

1946 Elev. 1798 REPORT

4/24 Location

5/1 10" @ 208
Drlg 2750

5/7 Arb 3276-78 TD
7" @ 3277 RUST

5/14 TD 3291-1200' oil 22 hrs
150 acid

5/21 500 acid
1000' oil 9 hrs

5/29 " " "

6/5 Swb. 6 oil per hr. 8 hrs.

6/12 " " "

6/18 " " "

6/26 " " "

7/3 " " "

7/10 Arb. 3276
7" @ 3277
650 acid.
TD 3292
Pump 292 Pot.
Grav. 42.0

COMPLETED

KANSAS Kansas Pool Name Stoltenberg

Map No. 50 Sec. 29 Twp. 17 R. 10W

Well No. 4 Janssen

H. V. Elwell Company

FIRST REPORT Contractor

SW SE NW

_____ Ft. from N. Line

330 Ft. from S. Line

990 Ft. from E. Line

_____ Ft. from W. Line

SECTION PLAT

	o		

Ellsworth County

Location X

Rig up _____

Drilling and Remarks:

RECORD

Cased _____ in., _____ ft.

Sand _____

Gas _____

Oil _____

Total Depth _____

PRODUCTION

1st 24 hrs. Nat. _____

1st 24 hrs. after shot _____

Gas _____ Cu. Ft.

Dry Hole _____

Abandoned _____

Date

APR 24 1946 19

S. J. LEWIS Scout

