

KANSAS

Ellsworth


Form 51-5M-7-40-Palace

Section 29 Township 17 Range 10-W

Well No. #2 Janssen

Company Gulf

NORTH Bloomer Pool

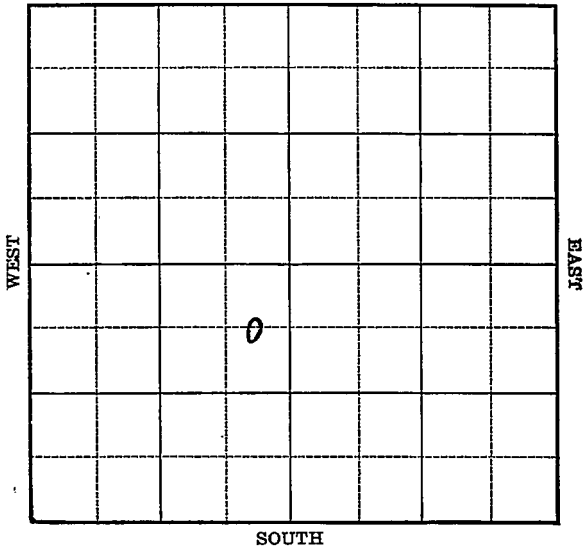

Sec. 29 Twp. 17 R. 10-W

Well No. #2 Janssen Farm
Gulf Company

(Bloomer)


660 Ft. from N. Line

_____ Ft. from S. Line

330 Ft. from E. Line

_____ Ft. from W. Line

Elev. 1807

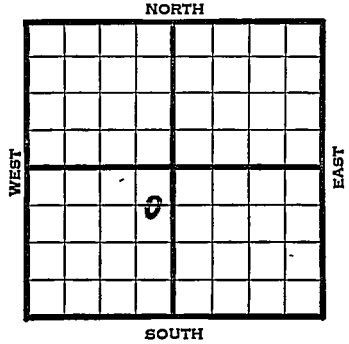

1941

REPORT

3/19 Derrick.

3/27 8" - 219' Drlg. 1585'

4/2 Drlg. 2875'

4/9 Re-work Arb. 3269'

T.D. 3332'

No shows.

ABANDONED

Map No. 55 Sec. 29 Twp. 17 R. 10WWell No. 2 JanssenGulf

Company

Contractor

FIRST REPORT**SECTION PLAT**

C E L N E SW

	o		

660 Ft. from N. Line

_____ Ft. from S. Line

330 Ft. from E. Line

_____ Ft. from W. Line

BLOOMER POOL

Location _____

Rig up _____

Drilling and Remarks:

Derrick

RECORD

Cased _____ in., _____ ft.

Sand _____

Gas _____

Oil _____

Total Depth _____

PRODUCTION

1st 24 hrs. Nat. _____

1st 24 hrs. after shot _____

Gas _____ Cu. Ft.

Dry Hole _____

Abandoned _____

Date

MAR 19 1941

19

S. J. LEWIS

Scout

Map No. 55 Sec. 29 Twp. 17 R. 10W

Well No. 2 Janssen

Gulf Company

ABANDONED Contractor

C E L N E S W

SECTION PLAT

660 Ft. from N. Line

_____ Ft. from S. Line

330 Ft. from E. Line

_____ Ft. from W. Line

BLOOMER POOL

Location _____

Rig up _____

Drilling and Remarks:

Re work KCU # 3269

Noshoro

RECORD

Cased _____ in., _____ ft.

Sand _____

Gas _____

Oil _____

Total Depth 332

PRODUCTION

1st 24 hrs. Nat. _____

1st 24 hrs. after shot _____

Gas _____ Cu. Ft.

Dry Hole _____

Abandoned _____

Date

APR 9 1941 19

S. J. LEWIS Scout