

Woodson

KANSAS

Section 19 Township 26 Range 15E

Well No. #1 Hill

Company G. L. Sheedy

NORTH

0							

WEST

EAST

SOUTH

Woodson

Sec. 19 Twp. 26 R. 15E

Well No. #1 Hill Farm

C. L. Sheedy Company

Contractor


330' Ft. from N. Line

_____ Ft. from S. Line

_____ Ft. from E. Line

330' Ft. from W. Line

NW NW NW

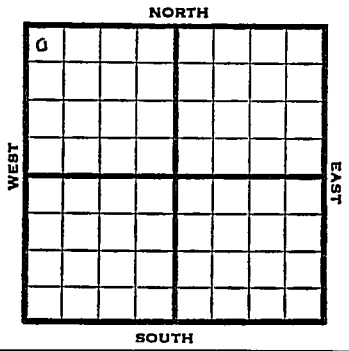

1951

REPORT

1/17

Bart. 1310 TD 1370' D&A

**FIRST REPORT
ABANDONED**

County Woodson State Kansas

Sec. 19 (Blk. 26) (Sur. Rge.) 15E Map No.

Operator C. L. Sheedy

Well No. 1 Farm Hill

Elev. Location NW NW NW

o					

FIRST REPORT
ABANDONED

330 Ft. From N Line NW

330 Ft. From W Line Quarter

Ist. Report JAN 17 1951

Completion JAN 17 1951

Remarks

Spudding Date

Drig. Data

Part. 1310 TD 1370 D & A