


Woodson

Map No. KS Sec. 20 Twp. 26 R. 15

Well No. 1 Englebracht Farm
Labov etal Company

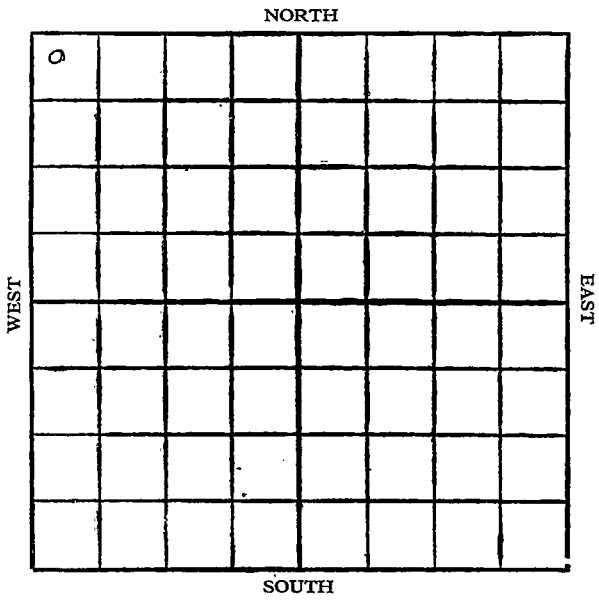

Location

Drilling Remarks

.....

.....

RECORD

Cased..... in. ft.

Sand

Gas

Oil

Total Depth.....

Rig Up.....

Drilling Remarks

.....

.....

PRODUCTION

1st 24 hrs. Nat.....

1st 24 hrs. after shot.....

Gas..... cu. ft.

Dry Hole.....

Abandoned.....

Woodson

Map No. *normal* **KANSAS** Sec. *20* Twp. *26* R. *15*

Well No. *1 longle brack.*

L. H. Bow et al Company

Contractor

SECTION PLAT

200 Ft. from N. Line

_____ Ft. from S. Line

_____ Ft. from E. Line

200 Ft. from W. Line

<i>ex</i>			

FIRST REPORTS

Location _____

Rig up _____

Drilling and Remarks:

Only 600'

RECORD

Cased _____ in., _____ ft.

Sand _____

Gas _____

Oil _____

Total Depth _____

PRODUCTION

1st 24 hrs. Nat. _____

1st 24 hrs. after shot _____

Gas _____ Cu. Ft.

Dry Hole _____

Abandoned _____

Date

NOV 1 1 1926

CHAS. L. SHERWOOD

192

Scout

Woodson

KANSAS Sec. 20 Twp. 26 R. 15

Well No. 1 Englebracht
Radon et al Company

Contractor

COMPLETED

SECTION PLAT

200 Ft. from N. Line

Ft. from S. Line

Ft. from E. Line

200 Ft. from W. Line

ABANDONED

0			

Location

Rig up

Drilling and Remarks:

Head 1224-1240

Show oil

top line 1444

DLG 1444 OFW

RECORD

Cased in, ft.

Sand

Gas

Oil

Total Depth 1444

PRODUCTION

1st 24 hrs. Nat.

1st 24 hrs. after shot

Gas Cu. Ft.

Dry Hole

Abandoned

Date

JAN 6 1927

CHAS. L. SHERWOOD