


Section 29 Township 17 Range 10W

Well No. #1 Janssen "B"

Company B. & R. Drilg. & Elwell

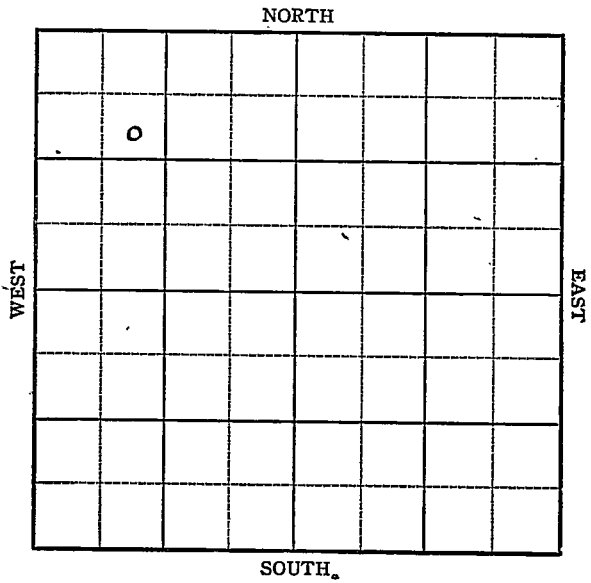

**KANSAS**


Ellsworth

Sec. 29 Twp. 17 R. 10~~W~~

Well No. #1 Janssen "B" Farm 2

B. & R. Drlg. & Elwell Company

NORTH

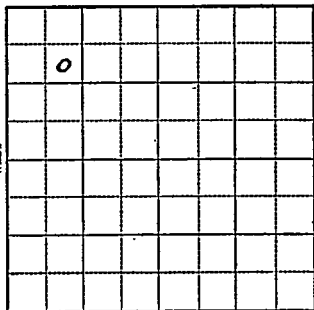

990 Ft. from N. Line

\_\_\_\_\_ Ft. from S. Line

\_\_\_\_\_ Ft. from E. Line

990 Ft. from W. Line

SOUTH

1944

R E P O R T

2/2 10" @ 240  
Anhy 555  
Drlg. 2060'

2/8 Lans 2934  
Arb 3291  
Drlg. 3299

2/16 Arb 3291  
TD 3305  
No shows

**ABANDONED**

~~KANSAS~~

Map No. 55 Sec. 29 Twp. 17 R. 10W

Well No. 1 Janssen "B"

B. & R. Drlg. & Elwell Company

**FIRST REPORT** Contractor

SE NW NW

**SECTION PLAT**

990 Ft. from N. Line

\_\_\_\_\_ Ft. from S. Line

\_\_\_\_\_ Ft. from E. Line

990 Ft. from W. Line

o			

**Bloomer Pool**

Location \_\_\_\_\_

Rig up \_\_\_\_\_

Drilling and Remarks:

10" - 240

Anhy. 555

2060

**RECORD**

Cased \_\_\_\_\_ in., \_\_\_\_\_ ft.

Sand \_\_\_\_\_

Gas \_\_\_\_\_

Oil \_\_\_\_\_

Total Depth \_\_\_\_\_

**PRODUCTION**

1st 24 hrs. Nat. \_\_\_\_\_

1st 24 hrs. after shot \_\_\_\_\_

Gas \_\_\_\_\_ Cu. Ft.

Dry Hole \_\_\_\_\_

Abandoned \_\_\_\_\_

Date

FEB 2 1944 19

S. J. LEWIS Scout

**KANSAS**

Map No. 55 Sec. 29 Twp. 17 R. 10W

Well No. 1 Janssen "B"

B & R Drlg. & Elwell Company

ABANDONED Contractor

SE NW NW

SECTION PLAT

990 Ft. from N. Line

\_\_\_\_\_ Ft. from S. Line

\_\_\_\_\_ Ft. from E. Line

990 Ft. from W. Line

e			

**Bloomer Pool**

Location \_\_\_\_\_

Rig up \_\_\_\_\_

Drilling and Remarks:

*See 43291  
No show*

RECORD

Cased \_\_\_\_\_ in., \_\_\_\_\_ ft.

Sand \_\_\_\_\_

Gas \_\_\_\_\_

Oil \_\_\_\_\_

Total Depth 3305

PRODUCTION

1st 24 hrs. Nat. \_\_\_\_\_

1st 24 hrs. after shot \_\_\_\_\_

Gas \_\_\_\_\_ Cu. Ft.

Dry Hole \_\_\_\_\_

Abandoned \_\_\_\_\_

Date

FEB 16 1944 19

S. J. LEWIS Scout