

Noodson

Form 51-5M-9-28-27423

Map No. **KANSAS** Sec. *20* Twp. *26* R. *15*

Well No. *1- Einglerecht* Farm

Allison Fitzwilliam Company

NORTH

WEST

EAST

0								

SOUTH

Location.....
 Drilling Remarks.....

Rig Up.....
 Drilling Remarks.....

RECORD

Cased..... in..... ft.
 Sand.....
 Gas.....
 Oil.....
 Total Depth.....

PRODUCTION

1st 24 hrs. Nat.....
 1st 24 hrs. after shot.....
 Gas..... cu. ft.....
 Dry Hole.....
 Abandoned.....

Woodson

Form 252A-5M-5-28-Mid-West

Map No. KANSAS Sec. 20 Twp. 26 R. 15

Well No. 1 - Englebrecht Farm


Allison - Fitzwilliam Company

250 Ft. from N. Line

..... Ft. from S. Line

..... Ft. from E. Line

250 Ft. from W. Line

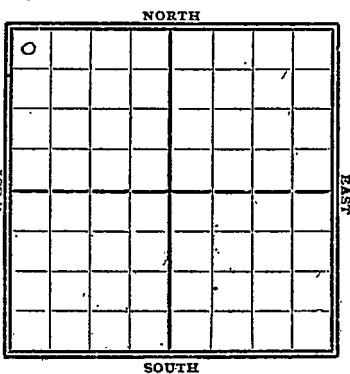

1929

Date

REPORT

1/12 sand 1224-40 = show
 sdy shale 1240-1420
 Top line 1444
 T.D. 1444'
 Dry & Abandoned

Woodson

E

Map No. *WAB 28* Sec. *20* Twp. *26* R. *15*

Well No. *1* *Englebrecht*

Allison Fitzwilliams Company

FIRST REPORTS Contractor

COMPLETE

SECTION PLAT

250 Ft. from N. Line

..... Ft. from S. Line

..... Ft. from E. Line

250 Ft. from W. Line

0			
ABANDONED			

Location.....

Rig up.....

Drilling and Remarks:

Sand 1274-40 Show
Sdy Shale 1240-1470'
Top line 1444'

RECORD

Cased ⁴..... in., ft.

Sand.....

Gas.....

Oil.....

Total Depth..... *1444'*

PRODUCTION

1st 24 hrs. Nat.....

1st 24 hrs. after shot.....

Gas..... Cu. Ft.

Dry Hole.

Abandoned.

Date .

Jan 17-1929 192 **CHAS. L. SHERWOOD** Scout