

Woodson County


KANSAS

FORM 51 5M BR1X

Section 27 Township 26S Range 17E

Well No. #1 Ladd

Company Ira Nourse et al

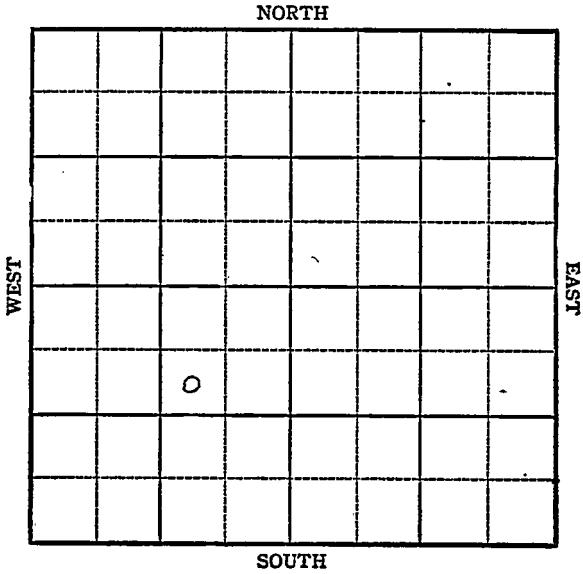

Sec. 27 Twp. 26 R. 17E

Well No. #1 Ladd Farm

Ira Nonrse etal Company


Wildcat

990 Ft. from N. Line

_____ Ft. from S. Line

990 Ft. from E. Line

_____ Ft. from W. Line

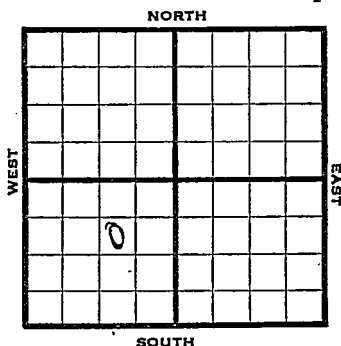

SW NE SW

R E P O R T

1944

12/27 Drlg. 1620'
SD

1945

1/3 " "

1/10 " "

1/17 " "

1/26 " "

1/31 " "

2/7 D775 SD

2/14 " "

2/21 " "

2/28 " "

3/7 " "

3/14 " "

3/23 " "

3/29 10" @ 1200'
Arb - 1465'
TD 1800' SD

4/5 " " "

4/12 " " "

4/20 " " "

4/27 " " "

5/3 " " "

OVER

1945

5/10 10" @ 1200
Arb. 1465
TD 1800' S.D.
5/17 " " " "
5/24 1850 SD
5/31 " "
6/8 " "
6/14 " "
6/21 8" @ 1887
TD 1925
UR 8"

~~6/28~~ " "
7/3 " "
7/11 " "
7/19 " "
7/26 " "
8/1 " "
8/8 " "
8/15 " "
8/22 " "
8/29 " "
9/5 " "
9/12 " "
9/19 " "
9/26 " "
10/3 " "
10/10 Drlg. 2240
10/17 " "
10/24 " "
10/31 " "
11/7 " "
11/14 " "
11/21 " "
11/28 " "
12/5 " "
12/12 " "
12/20 " "
12/29 " "

1946

1/9 TD 2240!

OVER

ABANDONED

Pool Name WildcatMap No. MM Sec. 27 Twp. 26 R. 17EWell No. 1 LaddIra Nourse et al. Company**FIRST REPORT**

Contractor

SW NE SW

SECTION PLAT990 Ft. from N. Line Ft. from S. Line990 Ft. from E. Line Ft. from W. Line

	o		

Woodson County

Location _____

Rig up _____

Drilling and Remarks:

1630 SD

RECORD

Cased _____ in., _____ ft.

Sand _____

Gas _____

Oil _____

Total Depth _____

PRODUCTION

1st 24 hrs. Nat. _____

1st 24 hrs. after shot _____

Gas _____ Cu. Ft.

Dry Hole _____

Abandoned _____

Date

DEC 27 1944 19S. J. LEWIS

Scout

KANSAS

Kansas Pool Name WildcatMap No. Wamego Sec. 27 Twp. 26 R. 17EWell No. 1 Ladd

Ira Nourse etal


Company

ABANDONED

Contractor

SW NE SW

SECTION PLAT

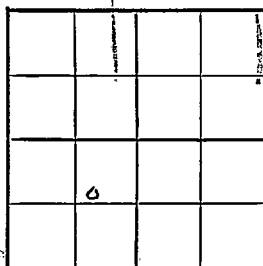990 Ft. from N. Line Ft. from S. Line990 Ft. from E. Line Ft. from W. Line

Woodson County

Location _____

Rig up _____

Drilling and Remarks:

RECORD.

Cased _____ in., _____ ft.

Sand _____

Gas _____

Oil _____

Total Depth 2240

PRODUCTION

1st 24 hrs. Nat. _____

1st 24 hrs. after shot. _____

Gas _____ Cu. Ft.

Dry Hole _____

Abandoned _____

Date

JAN 9 1946 19

S. J. LEWIS

Scout