


Woodson

KANSAS ✓

Section 32 Township 26 Range 15-E

Well No. 1 Hill

Company Ward McGinnis

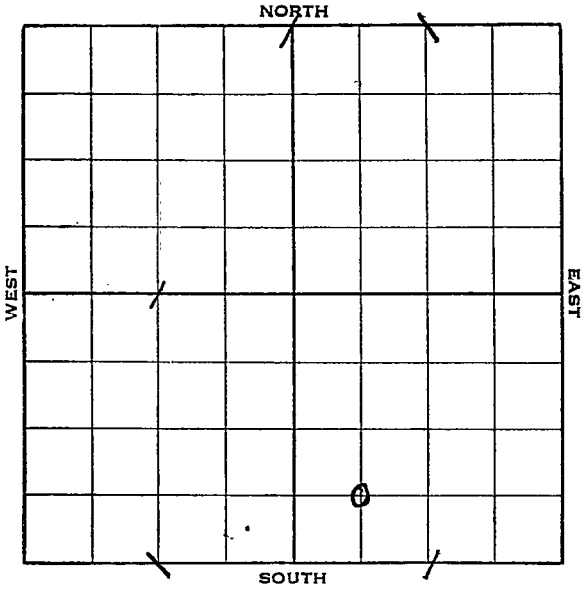

Sec. 32 Twp. 26 R. 15-E

Well No. #1 Hill Farm


Ward McGinnis Company

_____ Ft. from N. Line

660 Ft. from S. Line

_____ Ft. from E. Line

660 Ft. from W. Line

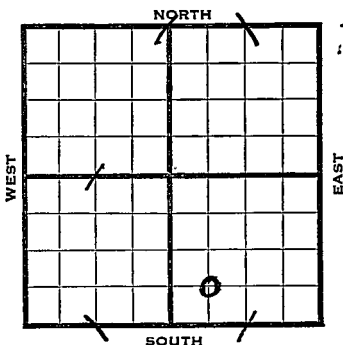

1938	REPORT
6/8	Spud.
6/17	10" @ 350'. Drlg. 760'.
6/22	Miss. 1315'.
	T. D. 1340'.
	H. F. W.
	ABANDONED

Woodson KANSAS

Map No. 17 Sec. 32 Twp. 26 R. 15EWell No. 1 HillWard McGinnis

Company

Contractor

FIRST REPORT

C SW SE

_____ Ft. from N. Line

660 Ft. from S. Line

_____ Ft. from E. Line

660 Ft. from W. Line

SECTION PLAT

Location _____

Rig up _____

Drilling and Remarks:

Spud

RECORD

Cased _____ in., _____ ft.

Sand _____

Gas _____

Oil _____

Total Depth _____

PRODUCTION

1st 24 hrs. Nat. _____

1st 24 hrs. after shot _____

Gas _____ Cu. Ft.

Dry Hole _____

Abandoned _____

Date

JUN 8 - 1938

19

H. D. Hatfield Scout

Map No. 17 Sec. 32 Twp. 26 R. 15EWell No. 1 HillWard McGinnis

Company

Contractor

ABANDONED

C SW SE

 Ft. from N. Line660 Ft. from S. Line Ft. from E. Line660 Ft. from W. Line

SECTION PLAT

		0	

Location Rig up

Drilling and Remarks:

HFW

DYA

RECORD

Cased in., ft.Sand MIS 1315Gas Oil Total Depth 1340

PRODUCTION

1st 24 hrs. Nat. 1st 24 hrs. after shot Gas Cu. Ft.Dry Hole Abandoned

Date

JUN 22 1938 19 H. D. Hatfield Scout