


E 11sworth county

Section 30 Township 17 Range 10-W

Well No. #2<sup>3</sup> Ehley (KGS DRL)

Company Herndon Drilling Company

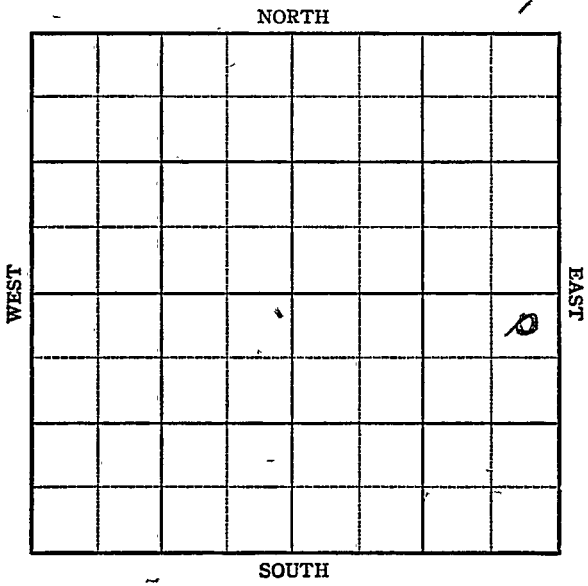

Sec. 30 KANSAS Twp. 17 R. 10-W ✓

Well No. #2 Ehley (K65 DRG) Farm


Herndon Drlg. Company  
Bloomer Pool

330' Ft. from N. Line

\_\_\_\_\_ Ft. from S. Line

330' Ft. from E. Line

\_\_\_\_\_ Ft. from W. Line

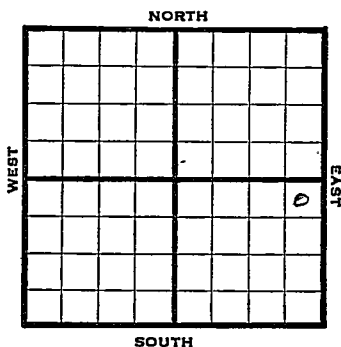

NE SE

1946	Elev. 1802 REPORT
12/18	8" @ 248' Drlg. 900'
1947	
1/4	Arb 3273-76 TD 5" @ 3274, RUST
1/8	TD 3283' Swb 18 oil PH 10 hrs.
1/15	" " "
1/21	" " "
1/29	TD 3283' Arb 3273 5" @ 3274 Pump 331 Pot. Gravity 42.

**COMPLETED**

Map No. \_\_\_\_\_ Sec. 30 Twp. 17 R. 10W

Well No. 2<sup>3</sup> Ehley (KGS DPL)

Herndon Drlg. \_\_\_\_\_ Company

FIRST REPORT \_\_\_\_\_ Contractor

NE SE

## SECTION PLAT

330 Ft. from N. Line

\_\_\_\_\_ Ft. from S. Line

330 Ft. from E. Line

\_\_\_\_\_ Ft. from W. Line

			o

Ellsworth County

Location \_\_\_\_\_

Rig up \_\_\_\_\_

Drilling and Remarks:

8" @ 248

drlg. 900

## RECORD

Cased \_\_\_\_\_ in., \_\_\_\_\_ ft.

Sand \_\_\_\_\_

Gas \_\_\_\_\_

Oil \_\_\_\_\_

Total Depth \_\_\_\_\_

## PRODUCTION

1st 24 hrs. Nat. \_\_\_\_\_

1st 24 hrs. after shot \_\_\_\_\_

Gas \_\_\_\_\_ Cu. Ft.

Dry Hole \_\_\_\_\_

Abandoned \_\_\_\_\_

Date

DEC 1 8 1946 19

S. J. LEWIS Scout

Map No. 55 Sec. 30 Twp. 17 R. 10W

Well No. 2<sup>3</sup> Ehley (KGS OBL)

Herndon Drlg.

Company

COMPLETE

Contractor

NE SE

*E. 11/802*

SECTION PLAT

330 Ft. from N. Line

\_\_\_\_\_ Ft. from S. Line

330 Ft. from E. Line

\_\_\_\_\_ Ft. from W. Line


Ellsworth County

Location \_\_\_\_\_

Rig up \_\_\_\_\_

Drilling and Remarks:

*Art 3223*

*5" @ 3224*

*Pump 331 Art*

*42 2/3*

RECORD

Cased \_\_\_\_\_ in, \_\_\_\_\_ ft.

Sand \_\_\_\_\_

Gas \_\_\_\_\_

Oil \_\_\_\_\_

Total Depth 2279

PRODUCTION

1st 24 hrs. Nat. \_\_\_\_\_

1st 24 hrs. after shot \_\_\_\_\_

Gas \_\_\_\_\_ Cu. Ft.

Dry Hole \_\_\_\_\_

Abandoned \_\_\_\_\_

Date

JAN 29 1947 19

S. J. LEWIS Scout