

Map No. K12 Sec. 24 Twp. 29 R. 3Well No. 1 GillumEmpire Company

Contractor

NORTH

WEST

FIRST REPORT

EAST

SOUTH

660' net

Location _____

Rig up _____

Drilling and Remarks:

J. O. G.

RECORD

Cased _____ in., _____ ft.

Sand _____

Gas _____

Oil _____

Total Depth _____

PRODUCTION

1st 24 hrs. Nat. _____

1st 24 hrs. after shot _____

Gas _____ Cu. Ft.

Dry Hole _____

Abandoned _____


Date

2/18 1919

Pyle

Scout

Map No. K12 Sec. 24 Twp. 29^S R. 3^E
Well No. 1 Gillum
Empire Company
Contractor

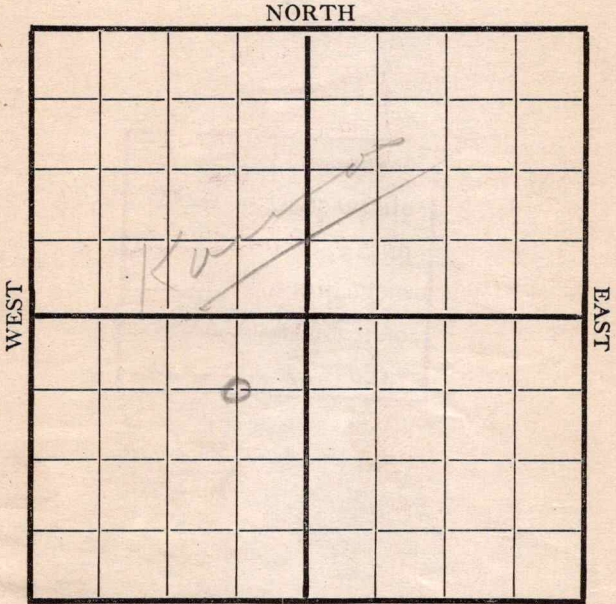


660 N-E SOUTH

Location _____ Rig up _____ Drilling and Remarks: <u>J.O. G.</u>	RECORD
	Cased _____ in., _____ ft.
	Sand _____
	Gas _____
	Oil _____
	Total Depth _____
	PRODUCTION
	1st 24 hrs. Nat. _____
	1st 24 hrs. after shot _____
	Gas _____ Cu. Ft.
	Dry Hole _____
	Abandoned _____

Date 7/25 1919 Cyle Scout

Map No. K12 Sec. 24 Twp. 29^S R. 3^E
 Well No. 1 Gillum
Empire Company
 Contractor

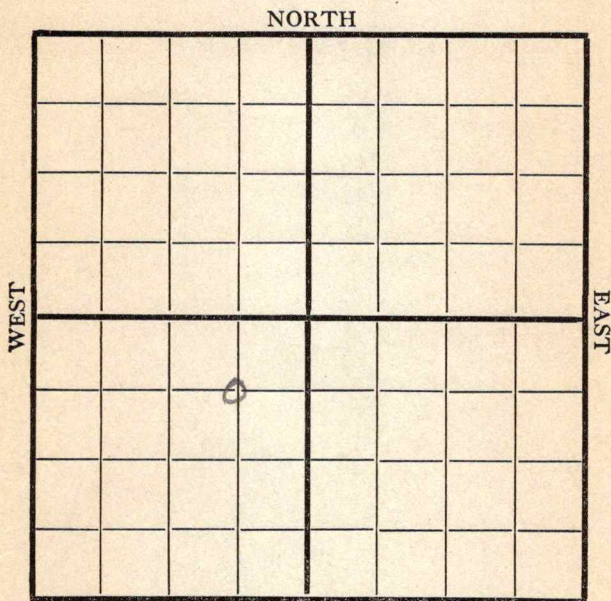

660 N-E

Location _____

Rig up ☒ _____

Drilling and Remarks: _____

RECORD

Cased _____ in., _____ ft.

Sand _____

Gas _____

Oil _____

Total Depth _____

PRODUCTION

1st 24 hrs. Nat. _____

1st 24 hrs. after shot _____

Gas _____ Cu. Ft.

Dry Hole _____

Abandoned _____

Date

3/5 1919

Pyle

Scout

Map No. K 12 Sec. 24 Twp. 29 R. 3 E

Well No. 1 William


Empire Company

Contractor

NORTH

WEST

EAST

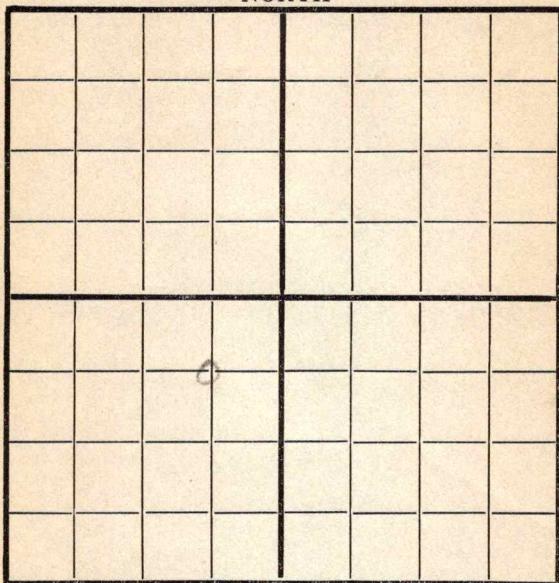

SOUTH

660 N-E

Location _____

Rig up ☒ _____

Drilling and Remarks:

RECORD

Cased _____ in., _____ ft.

Sand _____

Gas _____

Oil _____

Total Depth _____

PRODUCTION

1st 24 hrs. Nat. _____

1st 24 hrs. after shot _____

Gas _____ Cu. Ft.

Dry Hole _____

Abandoned _____

Date

3/14 1919 Oy Scout


Map No. 1512 Sec. 24 Twp. 29 R. 3Well No. 1 GillumEmpire Company

Contractor

NORTH

WEST

EAST

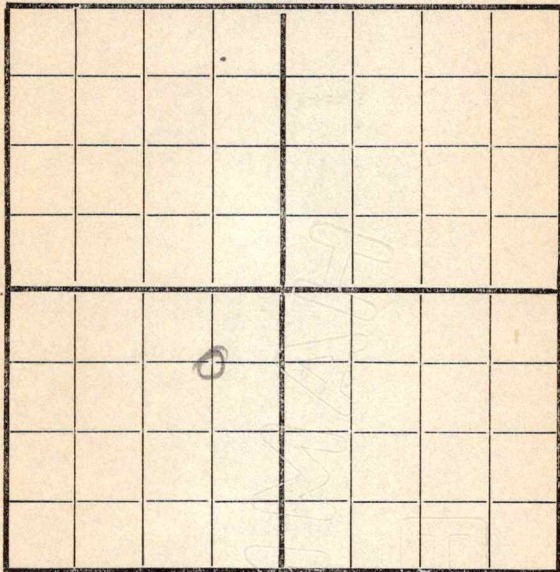

660 N-E SOUTH

Location _____

Rig up _____

Drilling and Remarks:

*Building
rig*

RECORD

Cased _____ in., _____ ft.

Sand _____

Gas _____

Oil _____

Total Depth _____

PRODUCTION

1st 24 hrs. Nat. _____

1st 24 hrs. after shot _____

Gas _____ Cu. Ft.

Dry Hole _____

Abandoned _____

Date

Pyle

191 9

Scout

3/20


Map No. K12 Sec. 24 Twp. 29 R. 3Well No. 1 LillianEmpire Company

Contractor

NORTH

WEST

EAST

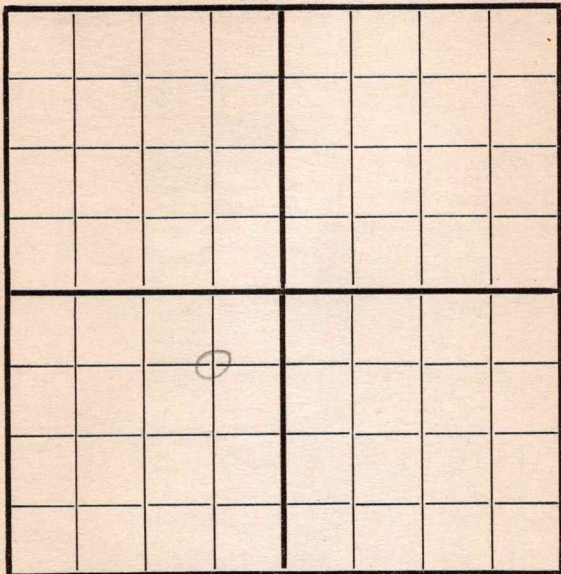

SOUTH

660 N-E

Location _____

Rig up _____

Drilling and Remarks:

Moving in tools

RECORD

Cased _____ in., _____ ft.

Sand _____

Gas _____

Oil _____

Total Depth _____

PRODUCTION

1st 24 hrs. Nat. _____

1st 24 hrs. after shot _____

Gas _____ Cu. Ft.

Dry Hole _____

Abandoned _____

Date

Pyle

Scout

19193/28


Map No. K12 Sec. 24 Twp. 29 R. 3Well No. 1Empire Company

Contractor

NORTH

WEST

EAST

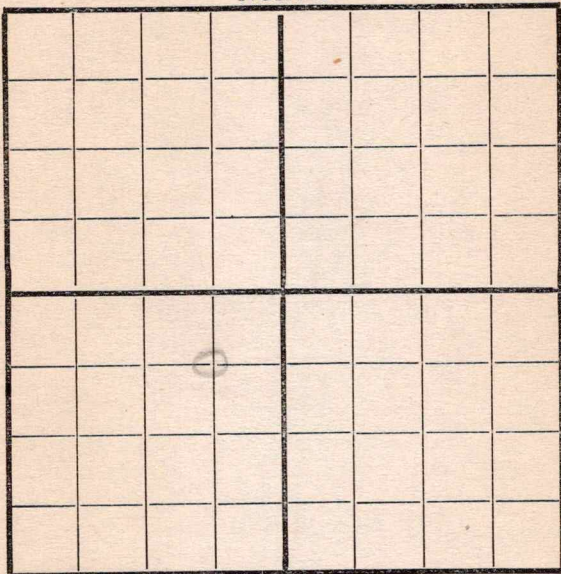

SOUTH

Location _____

Rig up _____

Drilling and Remarks:

Rigged up

RECORD

Cased _____ in., _____ ft.

Sand _____

Gas _____

Oil _____

Total Depth _____

PRODUCTION

1st 24 hrs. Nat. _____

1st 24 hrs. after shot _____

Gas _____ Cu. Ft.

Dry Hole _____

Abandoned _____

Date

4/2 1919

Pyle

Scout


Map No. K 12 Sec. 24 Twp. 29 R. 3Well No. 1 Gillum
Empire Company

Contractor

NORTH

WEST

EAST

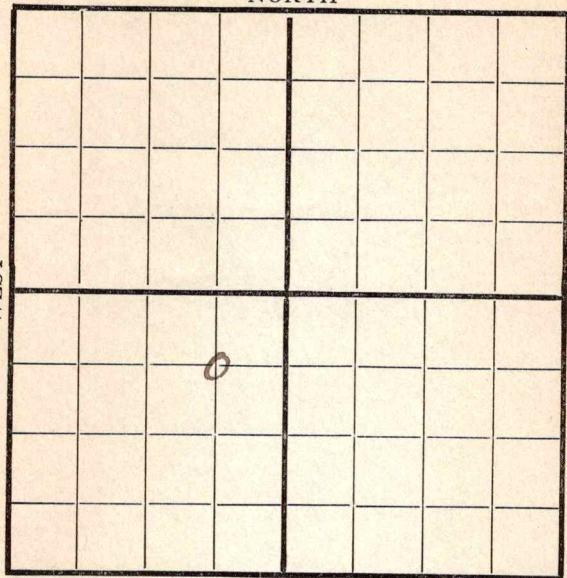

660 N-E SOUTH

Location _____

Rig up _____

Drilling and Remarks:

*Spud &
S.D.*

RECORD

Cased _____ in., _____ ft.

Sand _____

Gas _____

Oil _____

Total Depth _____

PRODUCTION

1st 24 hrs. Nat. _____

1st 24 hrs. after shot _____

Gas _____ Cu. Ft.

Dry Hole _____

Abandoned _____

Date

4/10 191 *9*

Pyle


Scout

Map No. K12 Sec. 24 Twp. 29 R. 3
 Well No. 1 Lillum
Empire Company
 Contractor

NORTH

WEST

EAST

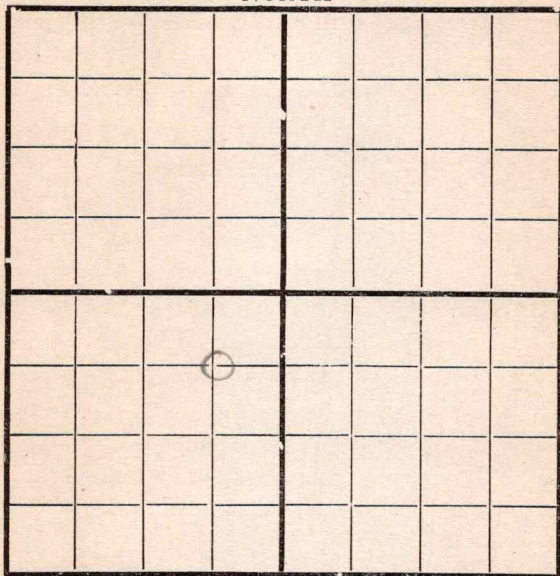

SOUTH

Location _____

Rig up _____

Drilling and Remarks:

15 1/2 @ 170'

RECORD

Cased _____ in., _____ ft.

Sand _____

Gas _____

Oil _____

Total Depth _____

PRODUCTION

1st 24 hrs. Nat. _____

1st 24 hrs. after shot _____

Gas _____ Cu. Ft.

Dry Hole _____

Abandoned _____

Date

191


9

Pyle

Scout

4/19

Map No. K12 Sec. 24 Twp. 29 R. 3
 Well No. 1 Gillum
Empire Company
 Contractor

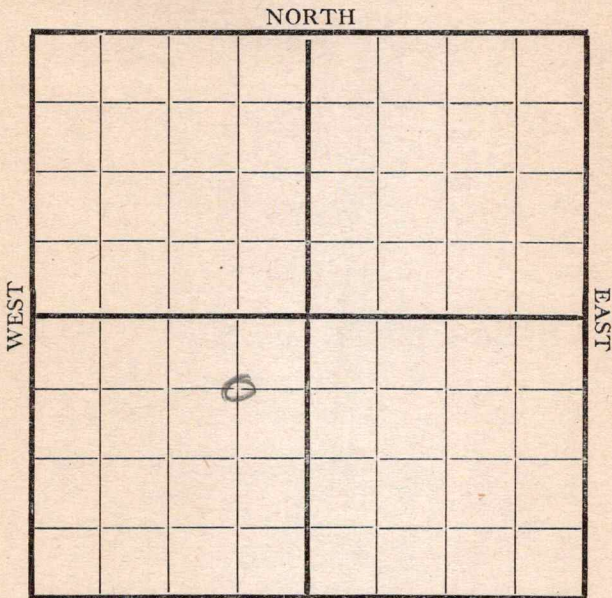

660 N-E

Location _____

Rig up _____

Drilling and Remarks:

810'

RECORD

Cased _____ in., _____ ft.

Sand _____

Gas _____

Oil _____

Total Depth _____

PRODUCTION

1st 24 hrs. Nat. _____

1st 24 hrs. after shot _____

Gas _____ Cu. Ft.

Dry Hole _____

Abandoned _____

Date


4/23 1919 Pyle Scout

Map No. 512 Sec. 24 Twp. 29 R. 3

Well No. 1 Illum
Empire Company

Contractor

NORTH

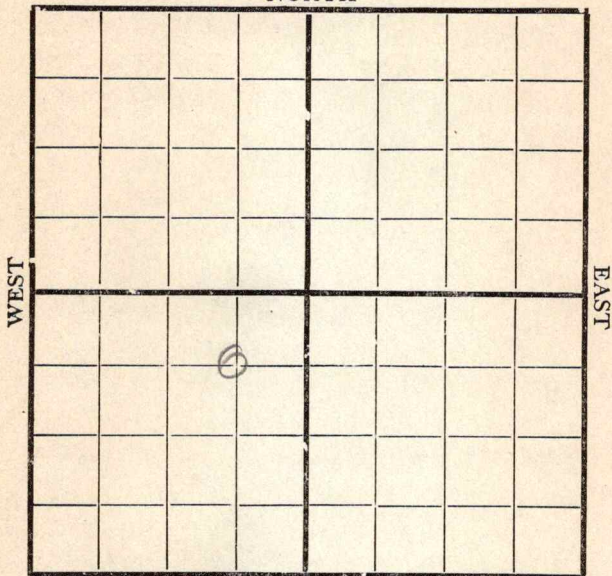

660 N-E SOUTH

Location _____

Rig up _____

Drilling and Remarks:

*fishing
tools @
1100'*

RECORD

Cased _____ in., _____ ft.

Sand _____

Gas _____

Oil _____

Total Depth _____

PRODUCTION

1st 24 hrs. Nat. _____

1st 24 hrs. after shot _____

Gas _____ Cu. Ft.

Dry Hole _____

Abandoned _____

Date

5/8 1919

Pyle

Scout

Map No. K12 Sec. 24 Twp. 29 R. 3
Well No. 1 Gillum
Empire Company
Contractor

NORTH

WEST								
								EAST

660 N-E SOUTH

Location _____
Rig up _____
Drilling and Remarks:

*fishing
tools @
1100'*

RECORD


Cased _____ in., _____ ft.
Sand _____
Gas _____
Oil _____
Total Depth _____

PRODUCTION

1st 24 hrs. Nat. _____
1st 24 hrs. after shot _____
Gas _____ Cu. Ft.
Dry Hole _____
Abandoned _____

Date 5/18 1919 Cyke Scout

Map No. K12 Sec. 24 Twp. 29 R. 3
 Well No. 1 Gillum
Empire Company
 Contractor

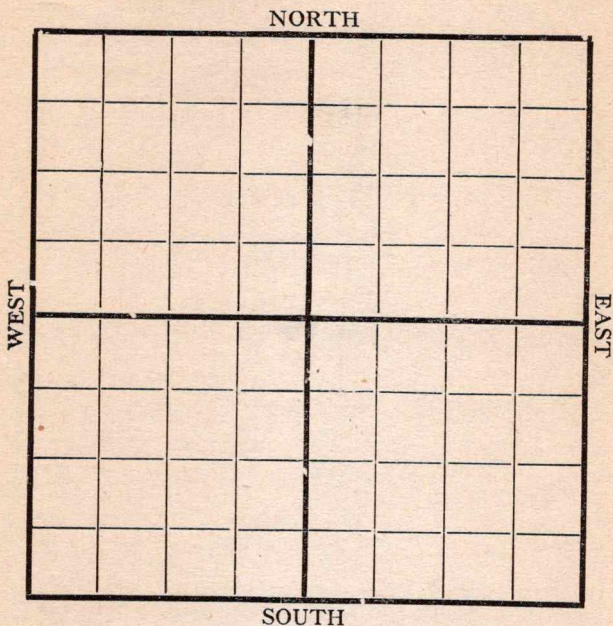

Location _____

Rig up _____

Drilling and Remarks:

HR 10" to 1120'

RECORD

Cased _____ in., _____ ft.

Sand _____

Gas _____

Oil _____

Total Depth _____

PRODUCTION

1st 24 hrs. Nat. _____

1st 24 hrs. after shot _____

Gas _____ Cu. Ft.

Dry Hole _____

Abandoned _____

Date

5/25 191*9*

Pyle

Scout


Map No. K12 Sec. 24 Twp. 29 R. 3Well No. 1 GillmanEmpire Company

Contractor

NORTH

WEST

EAST

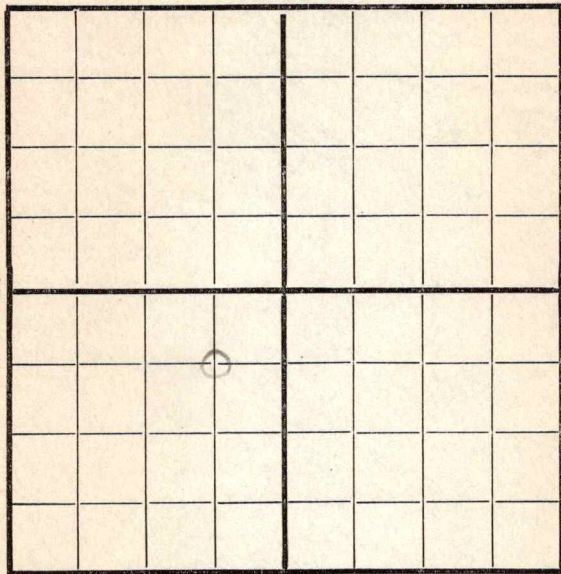

SOUTH

660 N-E

Location _____

Rig up _____

Drilling and Remarks:

1420'

RECORD

Cased _____ in., _____ ft.

Sand _____

Gas _____

Oil _____

Total Depth _____

PRODUCTION

1st 24 hrs. Nat. _____

1st 24 hrs. after shot _____

Gas _____ Cu. Ft.

Dry Hole _____

Abandoned _____

Date

Pyle

191 9

Scout

28


Map No. K12 Sec. 24 Twp. 29 R. 3Well No. 1 GillumEmpire Company

Contractor

NORTH

WEST

EAST

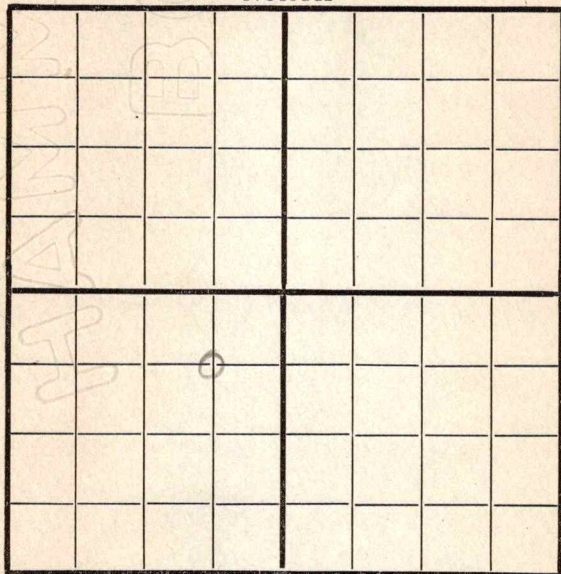

SOUTH

660 N-E

Location _____

Rig up _____

Drilling and Remarks:

RECORD

Cased _____ in., _____ ft.

Sand _____

Gas _____

Oil _____

Total Depth _____

PRODUCTION

1st 24 hrs. Nat. _____

1st 24 hrs. after shot _____

Gas _____ Cu. Ft.

Dry Hole _____

Abandoned _____

Date

6/4 1919

Pyle

Scout


Map No. K12 Sec. 24 Twp. 29 R. 3Well No. 1 GillumEmpire Company

Contractor

NORTH

WEST

EAST

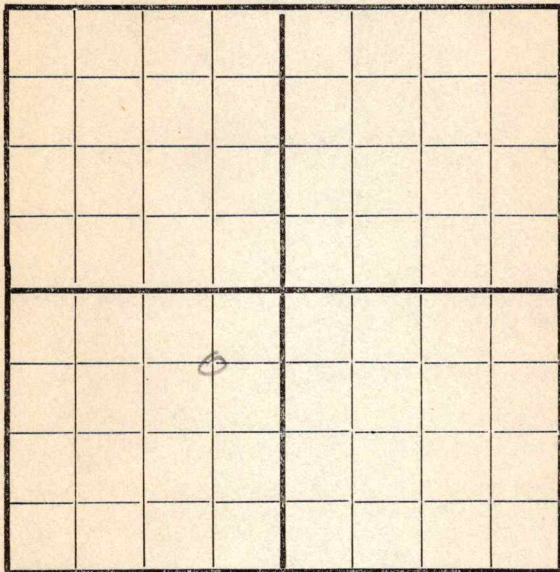

SOUTH

660 N-E

Location _____

Rig up _____

Drilling and Remarks:

Having
trouble with
10" @ 1700'

RECORD

Cased _____ in., _____ ft.

Sand _____

Gas _____

Oil _____

Total Depth _____

PRODUCTION

1st 24 hrs. Nat. _____

1st 24 hrs. after shot _____

Gas _____ Cu. Ft.

Dry Hole _____

Abandoned _____

Date

6/12 1919


Pyle

Scout

Map No. K 12 Sec. 24 Twp. 29 R. 3Well No. 1 GillumEmpire Company

Contractor

NORTH

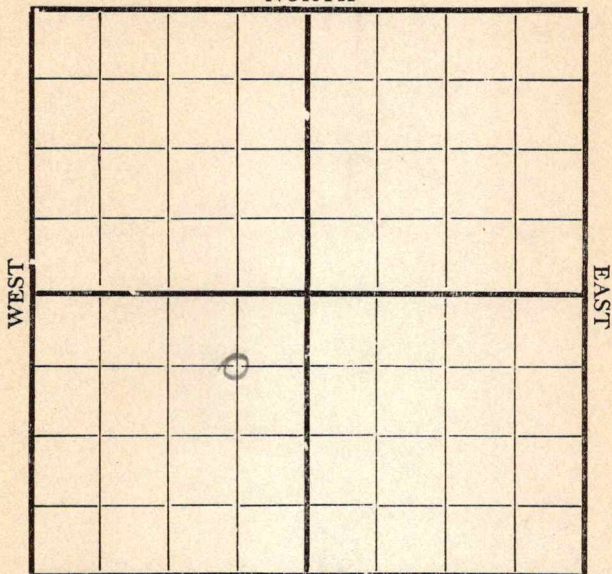

SOUTH

660 N-E

Location _____

Rig up _____

Drilling and Remarks:

N. R. 6 5/8 @1710'

RECORD

Cased _____ in., _____ ft.

Sand _____

Gas _____

Oil _____

Total Depth _____

PRODUCTION

1st 24 hrs. Nat. _____

1st 24 hrs. after shot _____

Gas _____ Cu. Ft.

Dry Hole _____

Abandoned _____

Date

6/1919Cyle

Scout

20


Map No. K12 Sec. 24 Twp. 29 R. 3Well No. 1 GillumEmpire Company

Contractor

NORTH

WEST

EAST

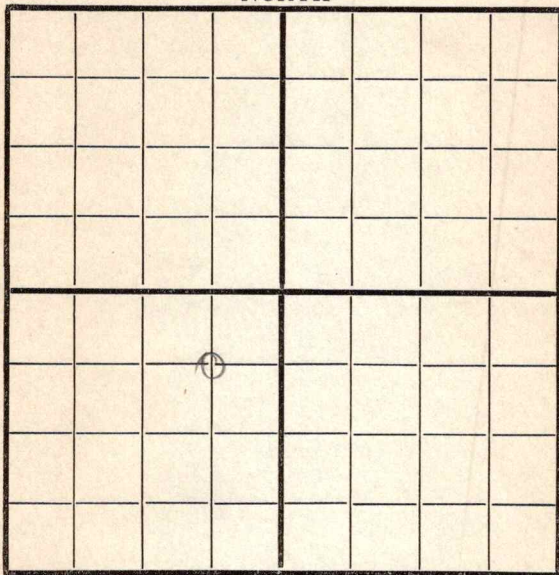

SOUTH

Location _____

Rig up _____

Drilling and Remarks:

RECORD

Cased _____ in., _____ ft.

Sand _____

Gas _____

Oil _____

Total Depth _____

PRODUCTION

1st 24 hrs. Nat. _____

1st 24 hrs. after shot _____

Gas _____ Cu. Ft.

Dry Hole _____


Abandoned _____

Date

1919

Scout

Map No. K12 Sec. 24 Twp. 29 R. 3
Well No. 1 Gillum
Empire Company
Contractor

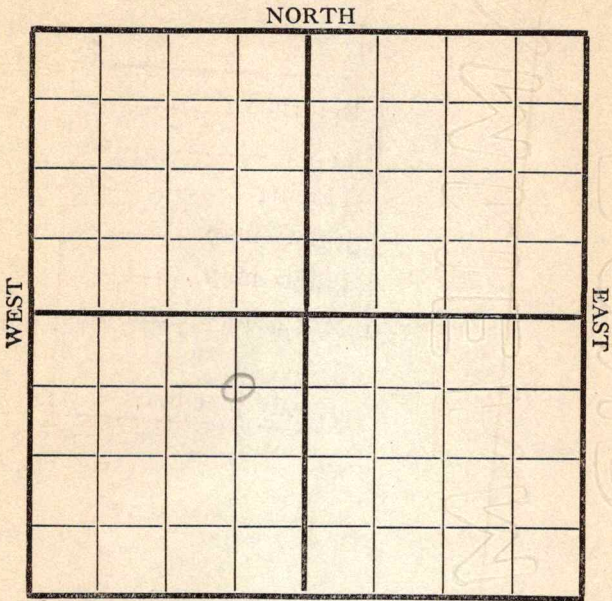

Location _____
Rig up _____
Drilling and Remarks:

2000'

RECORD

Cased _____ in., _____ ft.
Sand _____
Gas _____
Oil _____
Total Depth _____

PRODUCTION

1st 24 hrs. Nat. _____
1st 24 hrs. after shot _____
Gas _____ Cu. Ft.
Dry Hole _____
Abandoned _____


Date 7/6 1919 Oyle Scout

Map No. K12 Sec. 24 Twp. 29 R. 3
 Well No. 1 Gillum
Empire Company
 Contractor

NORTH

WEST

EAST

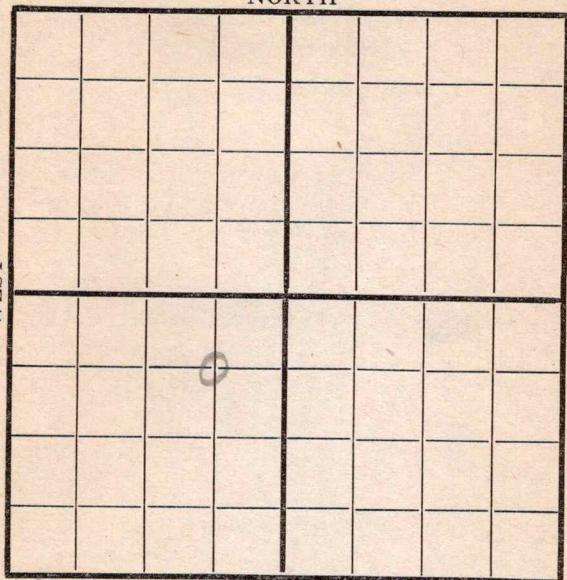

SOUTH

660 N-E

Location _____

Rig up _____

Drilling and Remarks:

RECORD

Cased _____ in., _____ ft.

Sand _____

Gas _____

Oil _____

Total Depth _____

PRODUCTION

1st 24 hrs. Nat. _____

1st 24 hrs. after shot _____

Gas _____ Cu. Ft.

Dry Hole _____

Abandoned _____

Date

7/12 1919


Gyle

Scout

Map No. K12 Sec. 24 Twp. 29 R. 3Well No. 1 GillumEmpire Company

Contractor

NORTH

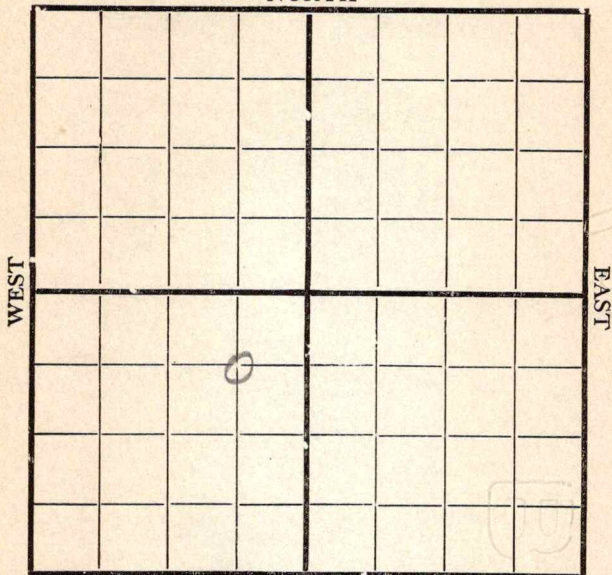

SOUTH

Location _____

Rig up _____

Drilling and Remarks:

2340'

RECORD

Cased _____ in., _____ ft.

Sand _____

Gas _____

Oil _____

Total Depth _____

PRODUCTION

1st 24 hrs. Nat. _____

1st 24 hrs. after shot _____

Gas _____ Cu. Ft.

Dry Hole _____

Abandoned _____

Date

7/18 191


Oyle Scout

Map No. K12 Sec. 24 Twp. 29 R. 3

Well No. 1 Gillum

Empire Company

Contractor

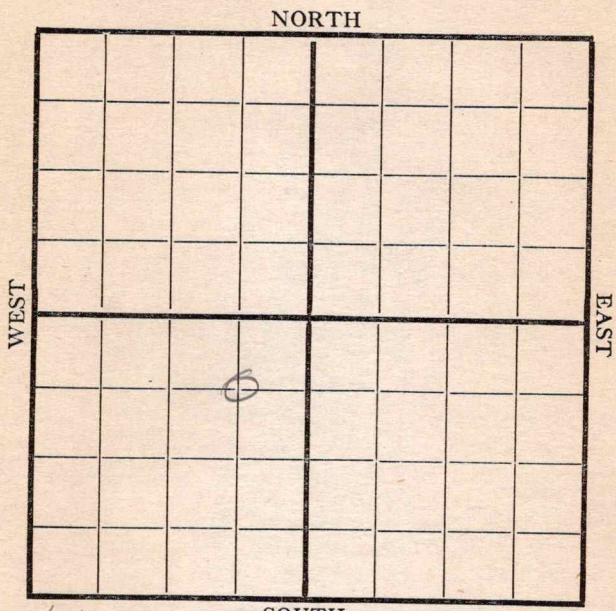

660 N. E

Location _____

Rig up _____

Drilling and Remarks:

S. 10 for
orders @
2340'

RECORD

Cased _____ in., _____ ft.

Sand _____

Gas _____

Oil _____

Total Depth _____

PRODUCTION

1st 24 hrs. Nat. _____

1st 24 hrs. after shot _____

Gas _____ Cu. Ft.

Dry Hole _____

Abandoned _____

Date

7/23 1919 July Scout

MAP NO. K12 **KANSAS** SEC. 34 TWP. 29S R. 3E

WELL NO. 1 Millum

Empire B+D COMPANY

CONTRACTOR

SECTION PLAT

ABANDONED

_____ FT. FROM N. LINE

_____ FT. FROM S. LINE

_____ FT. FROM E. LINE

_____ FT. FROM W. LINE

LOCATION _____

RIG UP _____

DRILLING AND REMARKS:

OK

RECORD

CASED _____ IN. _____ FT.

SAND _____

GAS _____

OIL _____

TOTAL DEPTH 2401

PRODUCTION

1ST 24 HRS. NAT. _____

1ST 24 HRS. AFTER SHOT _____

GAS _____ CU. FT.


DRY HOLE ☒

ABANDONED ☒

DATE

7/31 1919 SCOUT

Map No. K 12 Sec. 24 Twp. 29 R. 3
 Well No. Gillum
Empire Company
 Contractor

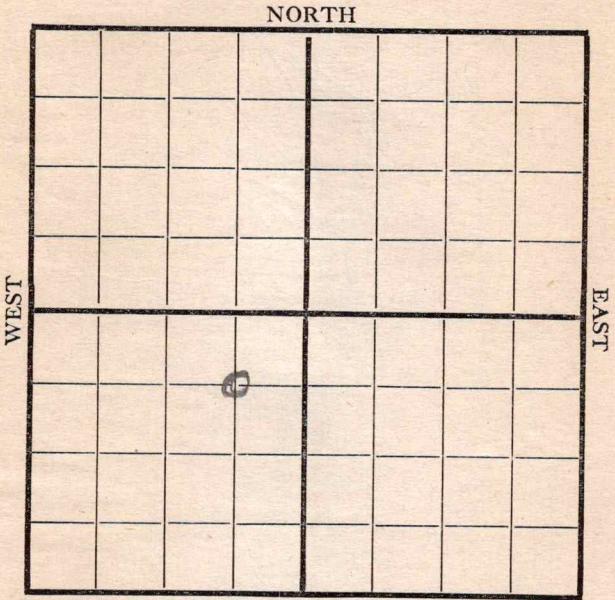

Location _____ Rig up _____ Drilling and Remarks: O. D. 1 @ 2165	RECORD Cased _____ in., _____ ft. Sand _____ Gas _____ Oil _____ Total Depth _____ PRODUCTION 1st 24 hrs. Nat. _____ 1st 24 hrs. after shot _____ Gas _____ Cu. Ft. Dry Hole _____ Abandoned _____
--	---

Date 8/3 1919 Pyle Scout


Map No. K 12 Sec. 24 Twp. 29 R. 3Well No. 1 LillumEmpire Company

Contractor

NORTH

WEST

EAST

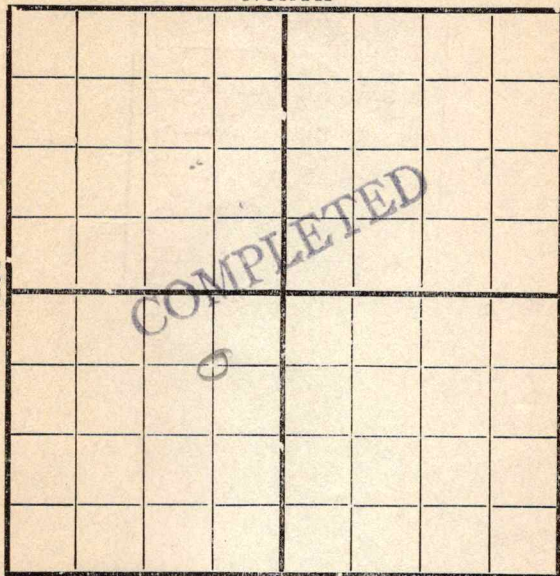

SOUTH

660 N.E

Location _____

Rig up _____

Drilling and Remarks:

RECORD

Cased _____ in., _____ ft.

Sand _____

Gas _____

Oil _____

Total Depth _____

PRODUCTION

1st 24 hrs. Nat. _____

1st 24 hrs. after shot _____

Gas _____ Cu. Ft.

Dry Hole 2401

Abandoned _____

Date

8/6 1919Tyler Scout