

Map No. _____ Sec. 16 Twp. 29 R. 3
Well No. 1 Walker Farm _____
Skaer & Hartman Company _____

NORTH

WEST

EAST

SOUTH

Location _____

Drilling Remarks:

Rig up _____

Drilling Remarks:

RECORD

Cased _____ in. _____ ft.

Sand _____

Gas _____

Oil _____

Total Depth_____

PRODUCTION

1st 24 hrs Nat. _____

1st 24 hrs. after shot_____

Gas _____ cu. ft.

Dry Hole_____

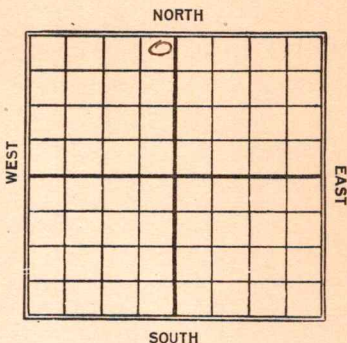
Abandoned _____

Map No. _____ Sec. 16 Twp. 29 R. 3Well No. 1 Walker FarmSkaen + Hartman Company200 Ft. from N. Line

_____ Ft. from S. Line

200 Ft. from E. Line

_____ Ft. from W. Line

Date
1923

REPORT

6/10Ring8/4Dlg 2623'8/15D. & A. 2890'

Map No. KANSAS W 16 Sec. 29 Twp. 3 R. 3

Well No. 1 Walker

Skur & Hartman Company

Contractor

FIRST REPORT

SECTION PLAT

200 Ft. from N. Line

_____ Ft. from S. Line

200 Ft. from E. Line

_____ Ft. from W. Line

	0		

Location _____

Rig up ✓

Drilling and Remarks:

RECORD

Cased _____ in., _____ ft.

Sand _____

Gas _____

Oil _____

Total Depth _____

PRODUCTION

1st 24 hrs. Nat. _____

1st 24 hrs. after shot _____

Gas _____ Cu. Ft.

Dry Hole _____

Abandoned _____

Date

JUN 10 1923

192

M. A. BENEAR

Scout

12 KANSAS Map No. _____ Sec. 16 Twp. 29 R. 3

Well No. 1 Walker
 Spencer & Hartman Company

Contractor _____

ABANDONED SECTION PLAT

200 Ft. from N. Line

Ft. from S. Line

200 Ft. from E. Line

Ft. from W. Line

	0		

Location _____

Rig up _____

Drilling and Remarks:

2049
 2890'

RECORD

Cased _____ in., _____ ft.

Sand _____

Gas _____

Oil _____

Total Depth _____

PRODUCTION

1st 24 hrs. Nat. _____

1st 24 hrs. after shot _____

Gas _____ Cu. Ft.

Dry Hole _____

Abandoned _____

Date

AUG 15 1923

M. A. BENEAR

192

Scout

Butler
 K12
 MAP NO. **KANSAS** SEC. *16* TWP. *29S* R. *3E*
 WELL NO. *1 M.C. Chappage*
Hartman & Sklar COMPANY

CONTRACTOR

ABANDONED

SECTION PLAT

_____ FT. FROM N. LINE
 _____ FT. FROM S. LINE
 _____ FT. FROM E. LINE
 _____ FT. FROM W. LINE

RECORD

LOCATION _____
 RIG UP _____
 DRILLING AND REMARKS:

CASED _____ IN. _____ FT.
 SAND _____
 GAS _____
 OIL _____
 TOTAL DEPTH *2890*

LTB

PRODUCTION

1ST 24 HRS. NAT. _____
 1ST 24 HRS. AFTER SHOT _____
 GAS _____ CU. FT. ✓
 DRY HOLE _____
 ABANDONED _____

DATE

8/3 192 *3* SCOUT