


Ellsworth

KANSAS

Section 30 Township 17 Range 10-W

Well Number 2 - Patzner

Company Phillips

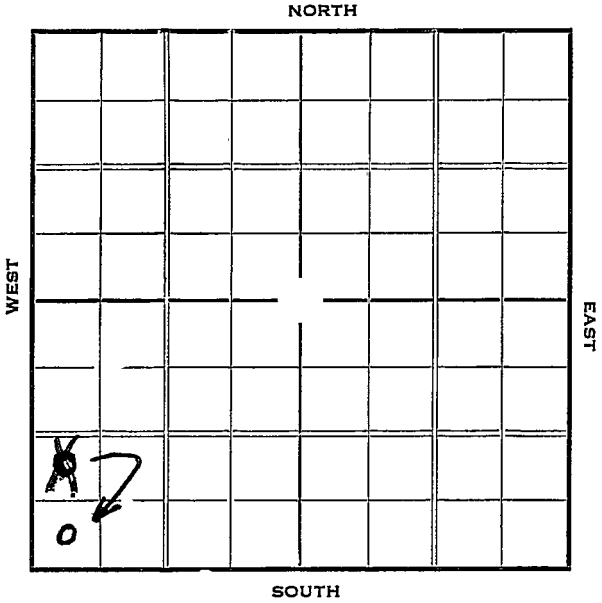

1937

8/11

7" @ 3305'.

Sil. 3305'.

T.D. 3311'.

2000 acid.

Pot. 1092 bbls.

Made 19 bbls. water per
hour on test.

COMPLETED

KANSAS *Ellsworth*

Map No. *55* Sec. *30* Twp. *17* R. *10^w*

Well No. *2-Patzner*

Phillips Company

Contractor

FIRST REPORT

SECTION PLAT

_____ Ft. from N. Line

990 Ft. from S. Line

_____ Ft. from E. Line

330 Ft. from W. Line

<i>0</i>			

Location _____

Rig up _____

Drilling and Remarks:

moving in material

RECORD

Cased _____ in., _____ ft.

Sand _____

Gas _____

Oil _____

Total Depth _____

PRODUCTION

1st 24 hrs. Nat. _____

1st 24 hrs. after shot _____

Gas _____ Cu. Ft.

Dry Hole _____

Abandoned _____

Date

MAY 12 1931 19

H. D. Hatfield Scout

Ellsworth KANSAS

Map No. 5-50 Sec. 30 Twp. 17 R. 10^w

Well No. 2 - Patzner

Phillips Company

Contractor

CORRECTION

_____ Ft. from N. Line

330 Ft. from S. Line

_____ Ft. from E. Line

330 Ft. from W. Line

SECTION PLAT

0			

Location _____

Rig up

Drilling and Remarks:

First reported as being located in NWSWSW

RECORD

Cased _____ in., _____ ft.

Sand _____

Gas _____

Oil _____

Total Depth _____

PRODUCTION

1st 24 hrs. Nat. _____

1st 24 hrs. after shot _____

Gas _____ Cu. Ft.

Dry Hole _____

Abandoned _____

Date

MAY 19 1937 19

H. D. Hatfield Scout

KANSAS Ellsworth

Map No. 54 Sec. 30 Twp. 17 R. 10 W

Well No. 2- Patner

Phillips Pet Company

Contractor

COMPLETED

_____ Ft. from N. Line

330 Ft. from S. Line

_____ Ft. from E. Line

330 Ft. from W. Line

SECTION PLAT

0			

Location _____

Rig up _____

Drilling and Remarks:

2000 Acid

Pat - 1092

Made 19 bbls water per hr on Test.

RECORD

Cased 7 in., 3305 ft.

Sand 511 3305

Gas _____

Oil _____

Total Depth 3311

PRODUCTION

1st 24 hrs. Nat. _____

1st 24 hrs. after shot _____

Gas _____ Cu. Ft.

Dry Hole _____

Abandoned _____

Date

AUG 11 1937 19

H. D. Hatfield

Scout