

KANSAS

Form 51-5M-7-39-Palace


Ellsworth

Section 30 Township 17 Range 10-W

Well No. #2 M. Stumps

Company Stanolind

NORTH Bloomer Pool

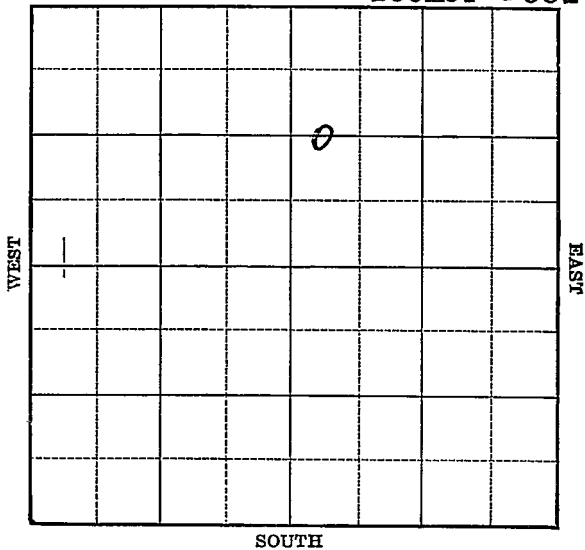

Sec. 30 Twp. 17 R. 10-W

Well No. #2 M. Stumps Farm

Stanolind Company

(Boomer)


1320 Ft. from N. Line

_____ Ft. from S. Line

_____ Ft. from E. Line

330 Ft. from W. Line

Elev. 1815

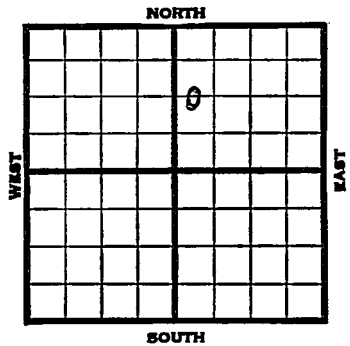

1939	REPORT
10/4	Location
10/12	"
10/19	"
10/26	"
11/2	"
11/9	Rotary.
11/16	8" - 223' Drlg. 2445'
11/22	Arb. 3308' water.
	T.D. 3319'
	ABANDONED

Map No. _____ Sec. 30 Twp. 17 R. 10WWell No. 2 M. StumpsStanolind

Company

Contractor

FIRST REPORT

C $W\frac{1}{2}$ $W\frac{1}{2}$ NE

SECTION PLAT

1320 Ft. from N. Line

_____ Ft. from S. Line

_____ Ft. from E. Line

330 Ft. from W. Line

		o	

BLOOMER POOL

Location X

Rig up _____

Drilling and Remarks:

RECORD

Cased _____ in., _____ ft.

Sand _____

Gas _____

Oil _____

Total Depth _____

PRODUCTION

1st 24 hrs. Nat. _____

1st 24 hrs. after shot _____

Gas _____ Cu. Ft.

Dry Hole _____

Abandoned _____

Date

OCT 4 1939₁₉S. J. LEWIS Scout

Map No. 55 Sec. 30 Twp. 17 R. 10WWell No. 2 M. StumpsStanolind

Company

Contractor

ABANDONED

C $W\frac{1}{2}$ $W\frac{1}{2}$ NE1320 Ft. from N. Line

_____ Ft. from S. Line

_____ Ft. from E. Line

330 Ft. from W. Line

BLOOMER POOL

SECTION PLAT

		o	

Location _____

Rig up _____

Drilling and Remarks:

*Cor 83308.**Water.*

RECORD

Cased _____ in., _____ ft.

Sand _____

Gas _____

Oil _____

Total Depth 3319

PRODUCTION

1st 24 hrs. Nat. _____

1st 24 hrs. after shot _____

Gas _____ Cu. Ft.

Dry Hole _____

Abandoned _____

Date

NOV 22 1939₁₉

S. J. LEWIS Scout